




T.18S. R.45E., W.M.

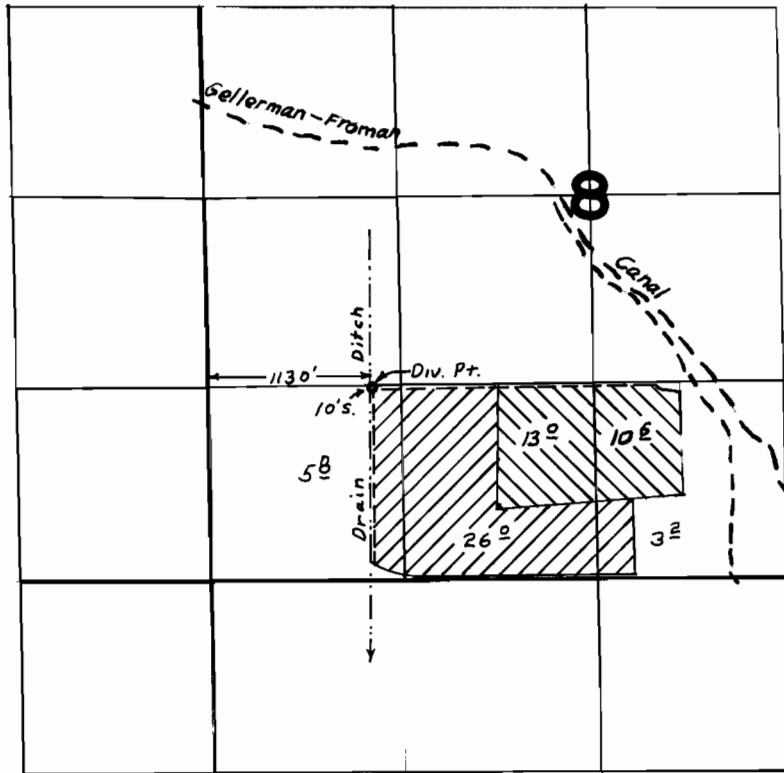

 Primary
 Certificate 48051

FINAL PROOF SURVEY UNDER

Application No. 41000..... Permit No. 30715.....
IN NAME OF

.....HERMAN H. MOLLER.....

Surveyed OCT. 14... 1970, by F. ELFERING.....