


T.2N.,R.32E.,W.M.

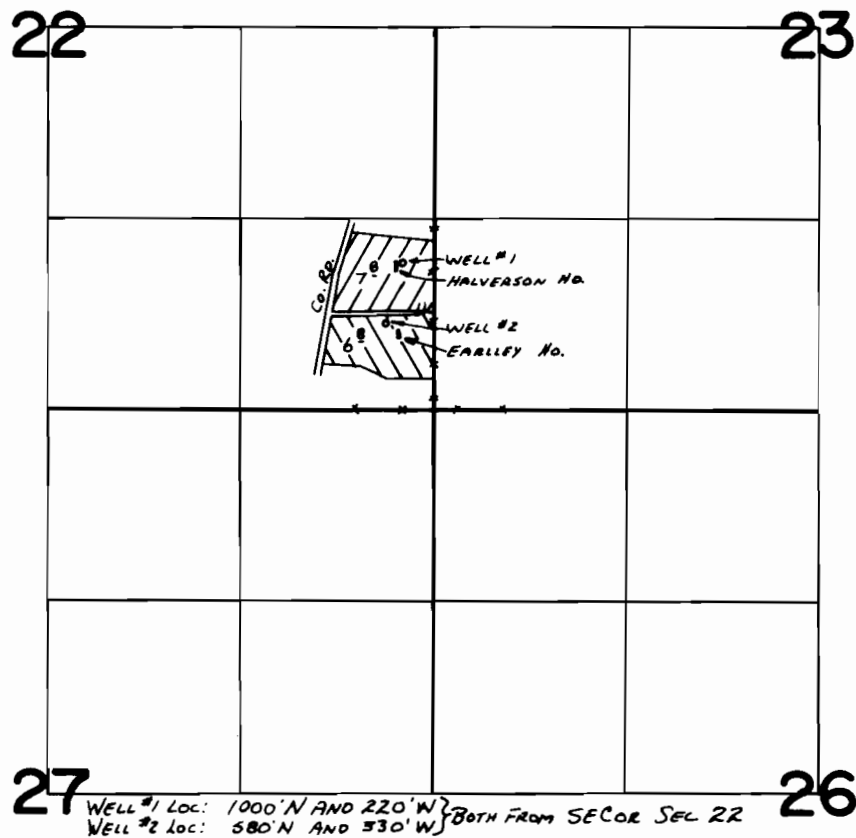

FINAL PROOF SURVEY
UNDER

Application No. G-5963. Permit No. G-5728.
IN NAME OF
LYLE L. EARLEY &
DALE J. HALVERSON

Surveyed APRIL 10, 1976, by L. TOLL