


T.1S. R.13E. W.M.

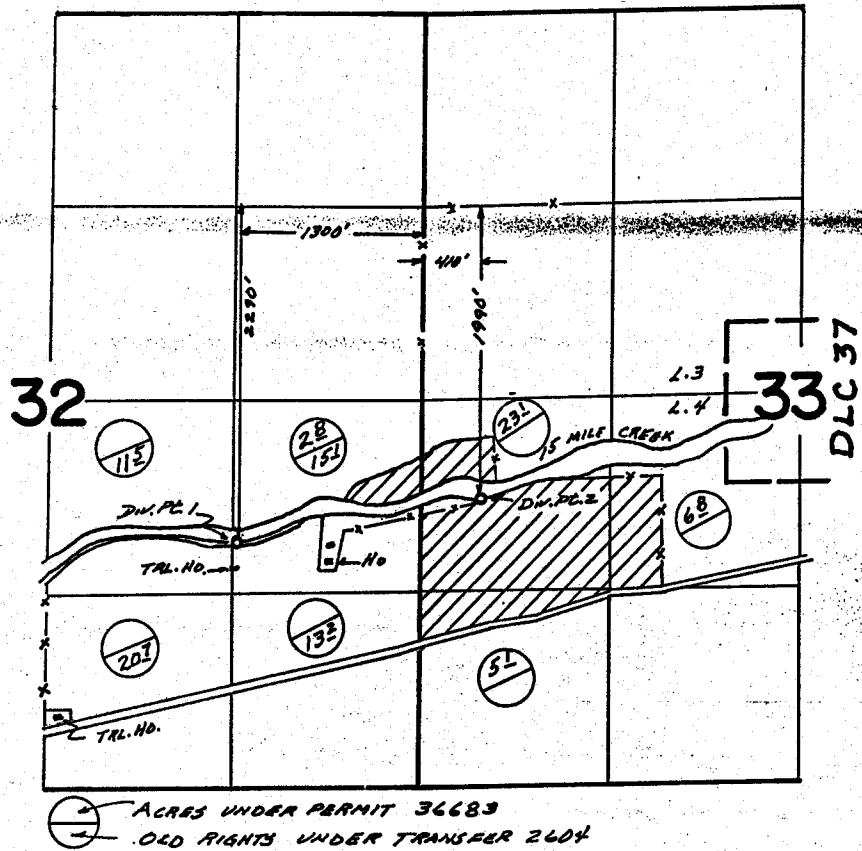

FINAL PROOF SURVEY UNDER

Transfer No. 2604
Application No. 49002... Permit No. 36683...
IN NAME OF

.....PAUL S.CHANNO.....

Surveyed Oct. 21... 1975., by T.J. PAUL.....