


T. 4S. R. 2E. W.M.

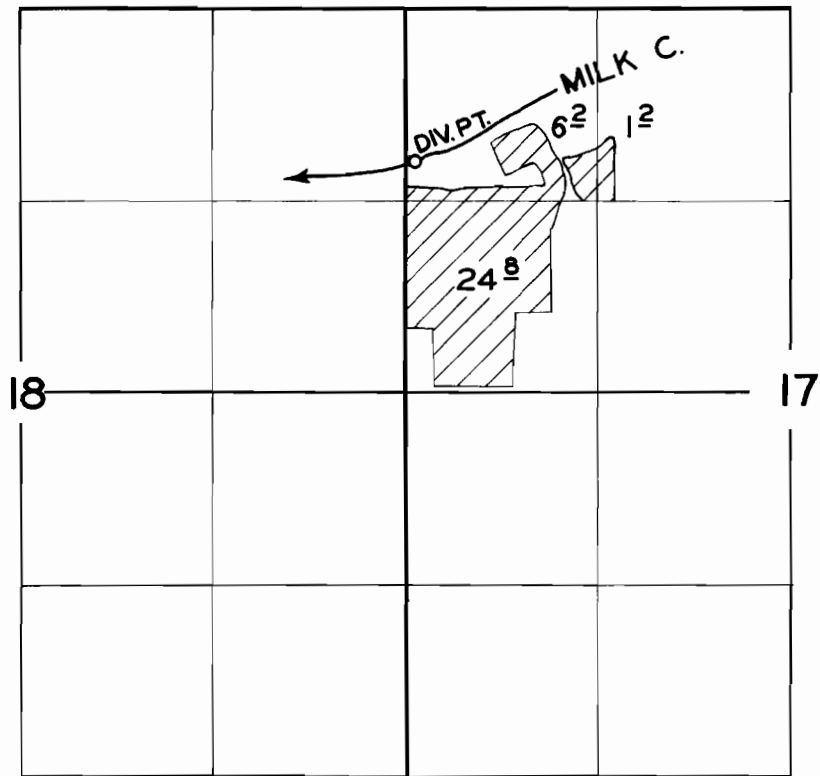

FINAL PROOF SURVEY
UNDER

Application No. 21328 Permit No. 16724
IN NAME OF

RAYMOND M. & JOSEPHINE E. JOHNSON

Surveyed 12.MAR. 1956, by R.D. BEST

Best