


T2S. R4 & 5E. WM.

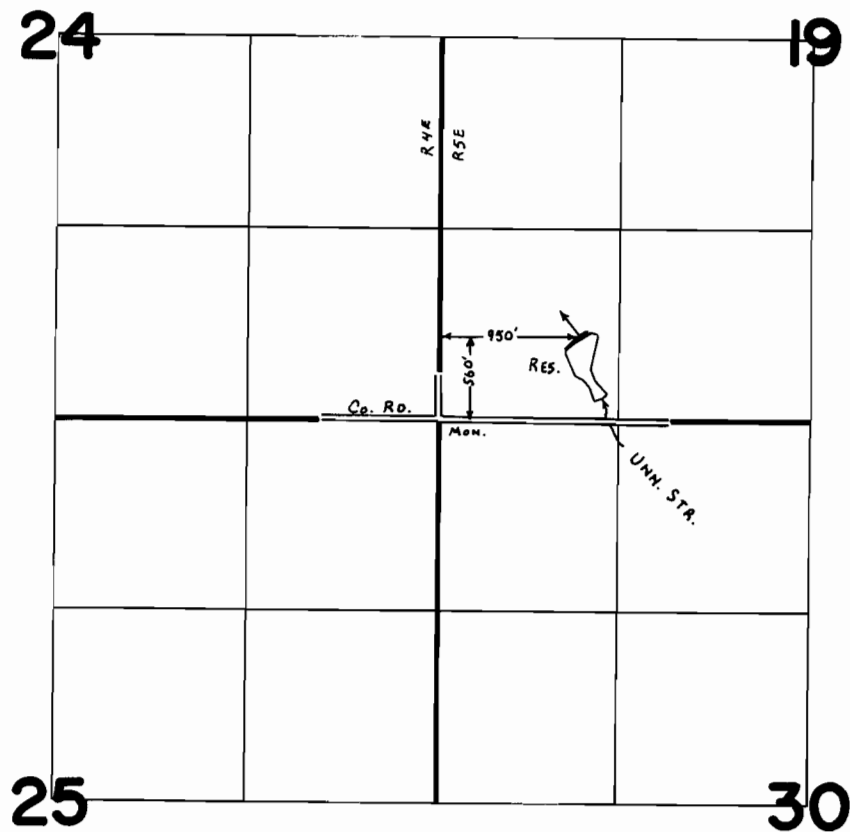

FINAL PROOF SURVEY
UNDER

R-51346 R-6218
Application No. 51861 Permit No. 38767
IN NAME OF

REO L. BACON

Surveyed May 9 1979, by R.G. MUCKEN