


PLAT OF ELIM FAUGHT'S DITCHES AND LANDS

Tp 19 S. R. 18 E. W.M.

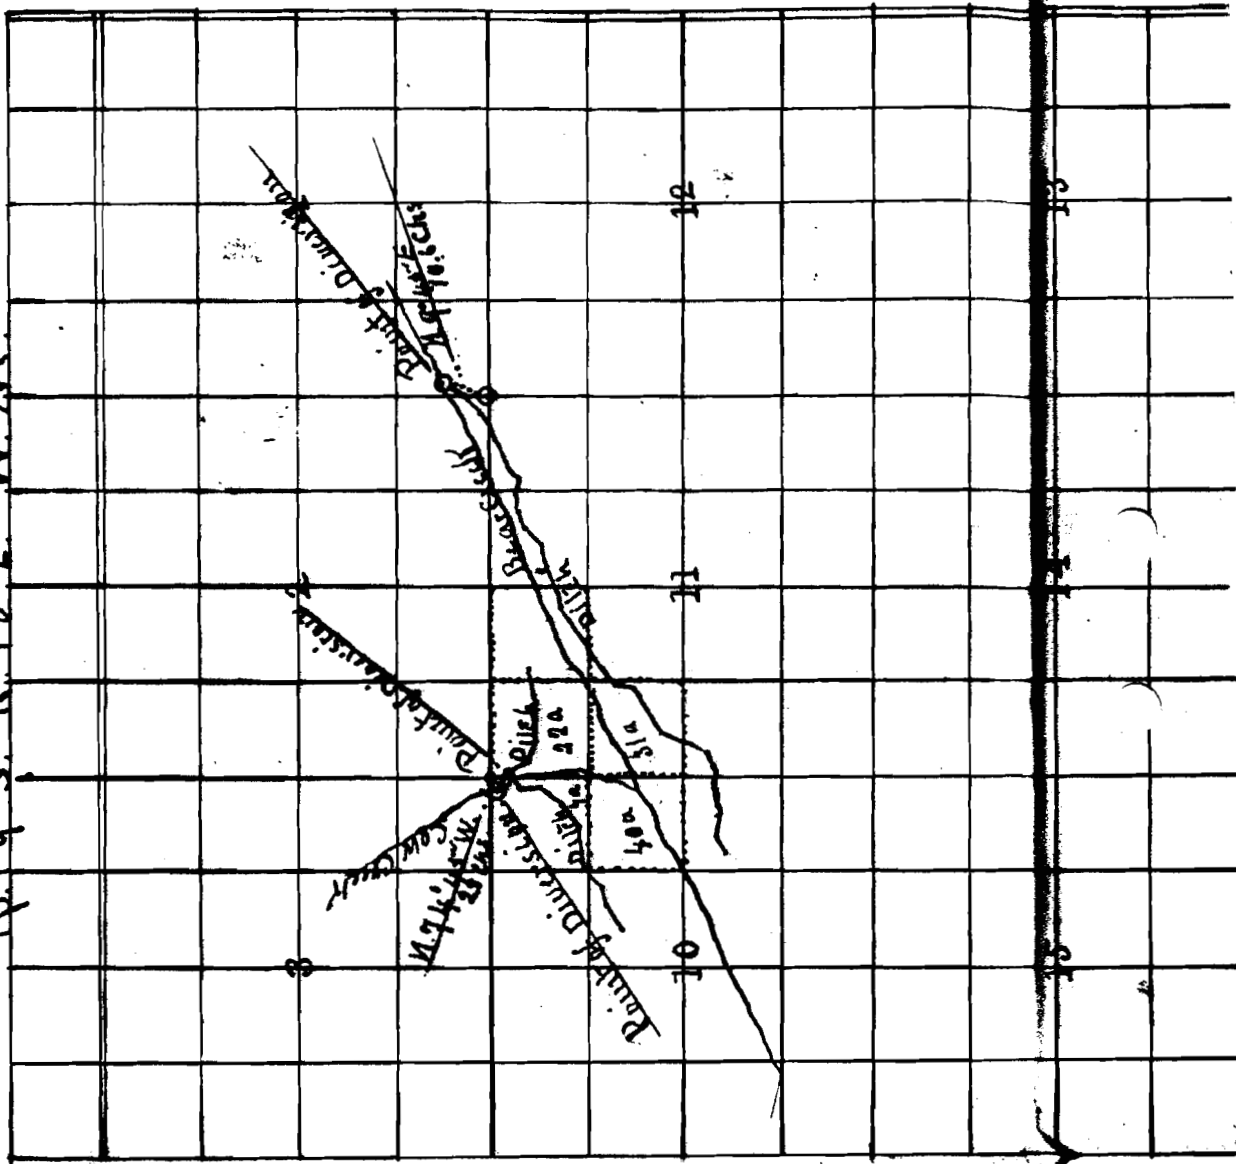

Application No. 1091
Permit No. 515

Application No. 1093
Permit No. 517

Scale 1 inch = 40 Chs.

State of Oregon } ss.
County of Brook

I, W. R. McFarland being
first duly sworn depose and say,
that am a surveyor by profession,
and that on Oct. 14, 1910, I actually
surveyed the ditches and irrigated
land on this map noted and
indicated, and that the same is
true and correct.

W. R. McFarland

Subscribed and sworn to
before me this ^{14th} day of Nov. 1910.

M. Ed Brink

Notary Public for Ore.

final plat map
780

515 + 517

C490
C491