


T.26S.R.4W.W.M.

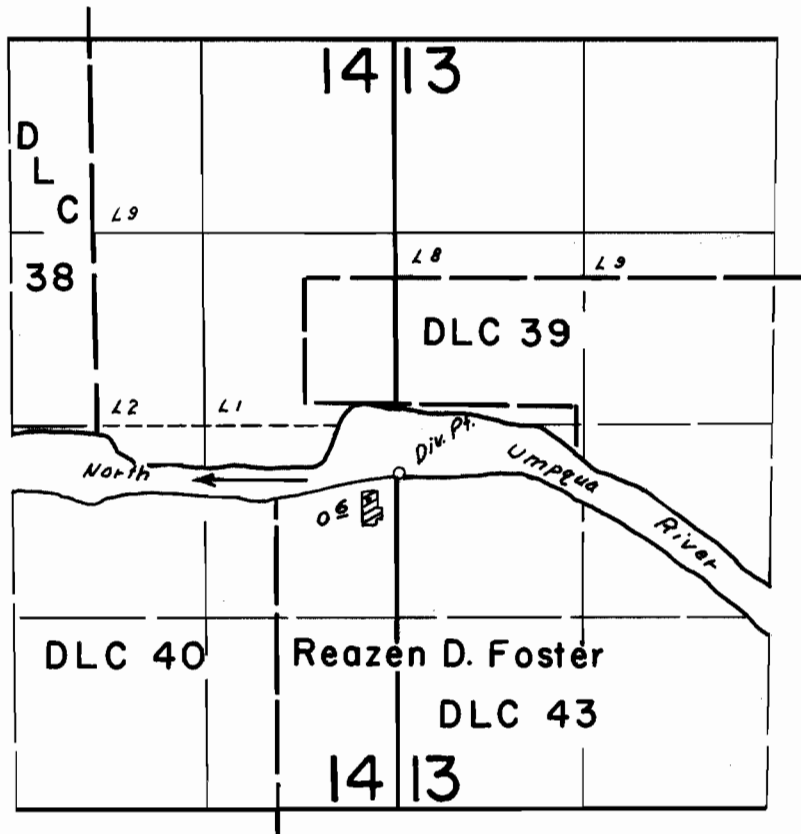

FINAL PROOF SURVEY
UNDER

Application No. 37470... Permit No. 27896...
IN NAME OF

BONNIE V. MERACLE

Surveyed July 29, 1964., by *C.D. Gardner*