


T.29S., R.3W., W.M.

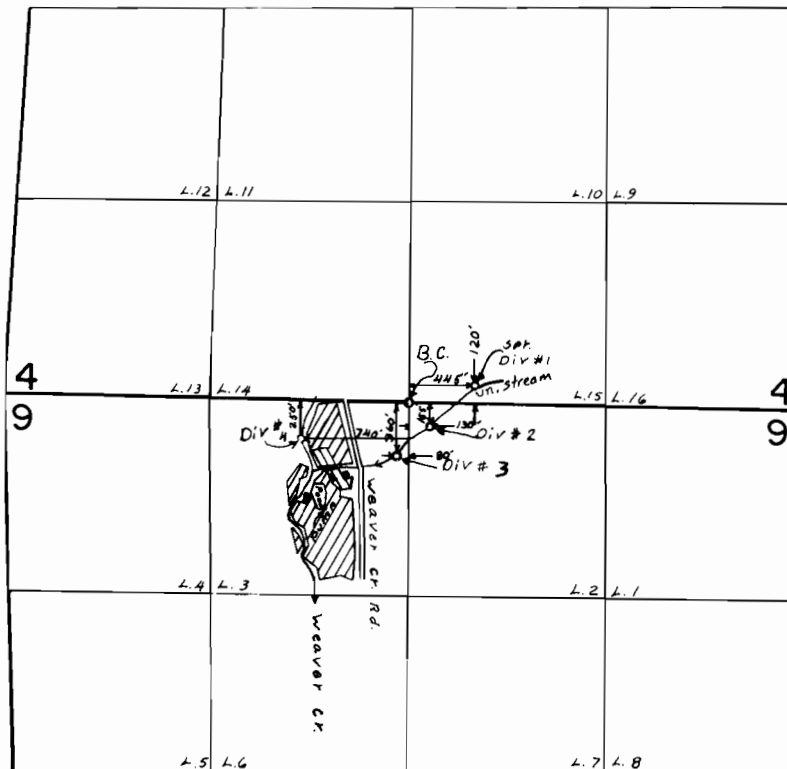

0.6 Unn. Stream
6.4 Weaver Creek & pond

FINAL PROOF SURVEY
UNDER

Application No. R-51141 51142 Permit No. R-6223 38805
IN NAME OF

FRANCIS F MOORE

Surveyed SEPT. 30 1977, by D.W. SPARKS