


T.26S. R.4W. W.M.

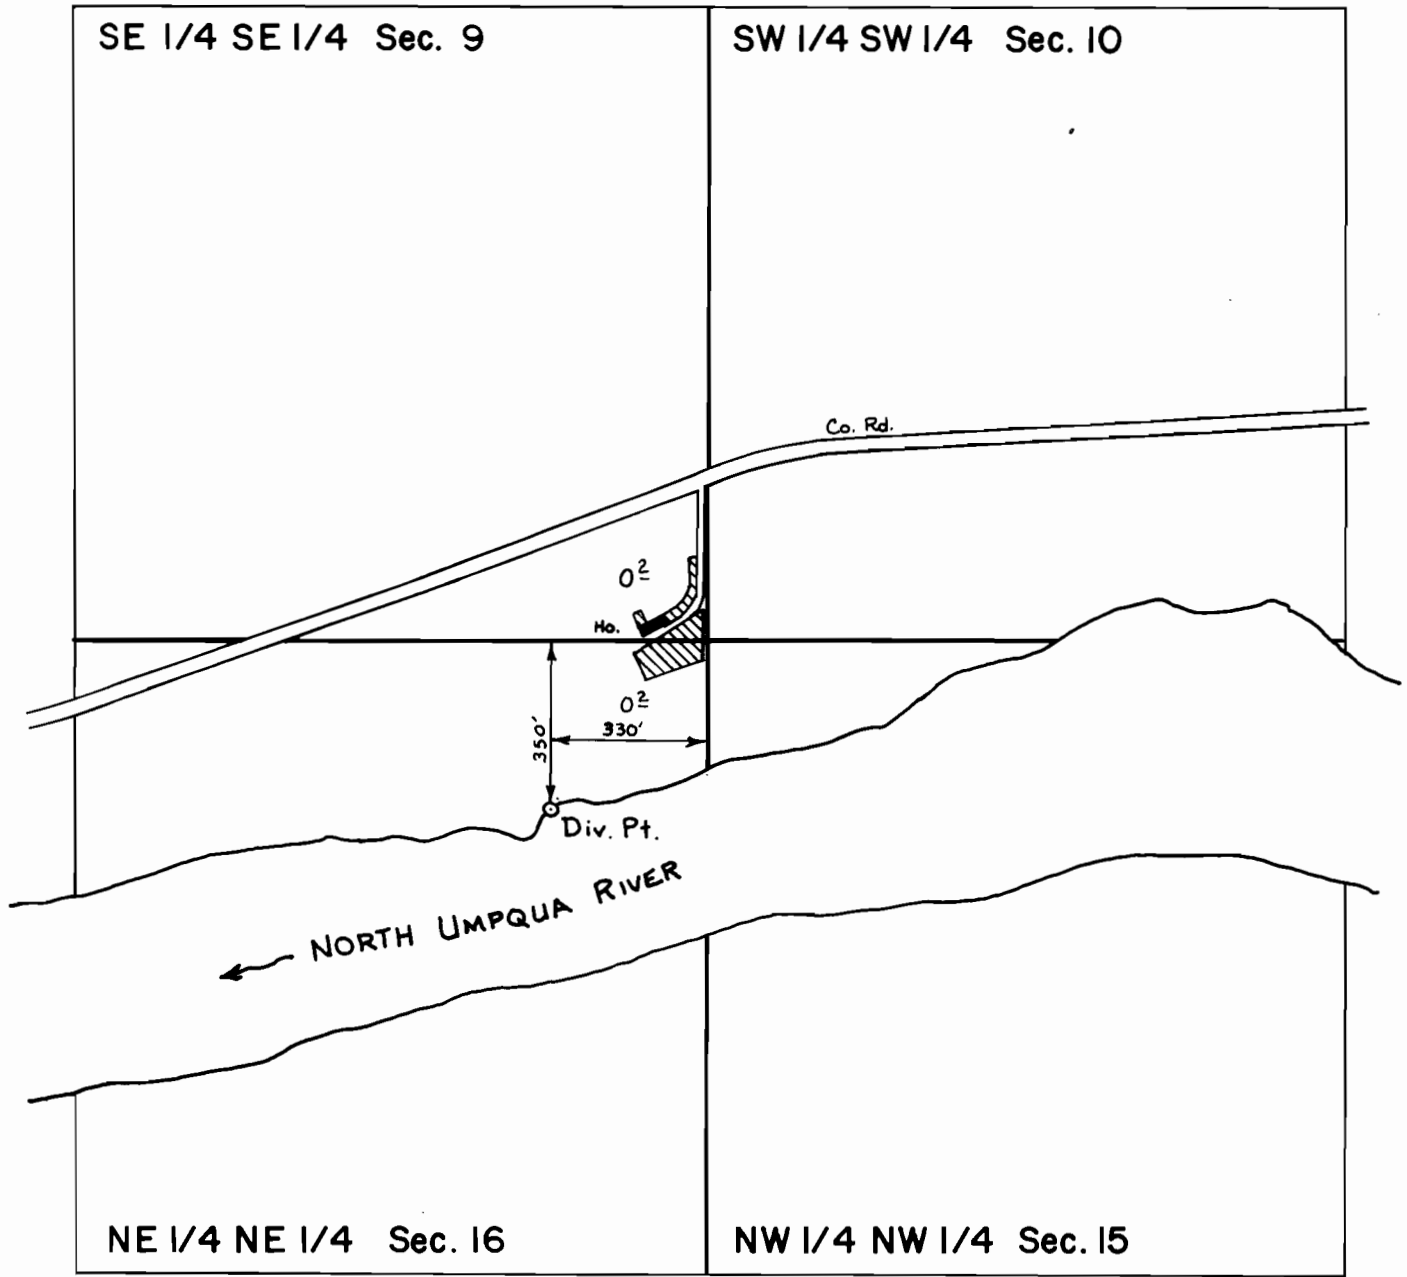

**FINAL PROOF SURVEY**  
UNDER

SCALE: 1" = 400'

Application No. 52670 Permit No. 39686  
IN NAME OF

CHARLES RICHARDS

Surveyed Oct. 11, 1977, by D. W. Sparks