


T. 29S. R. 5W. W.M.

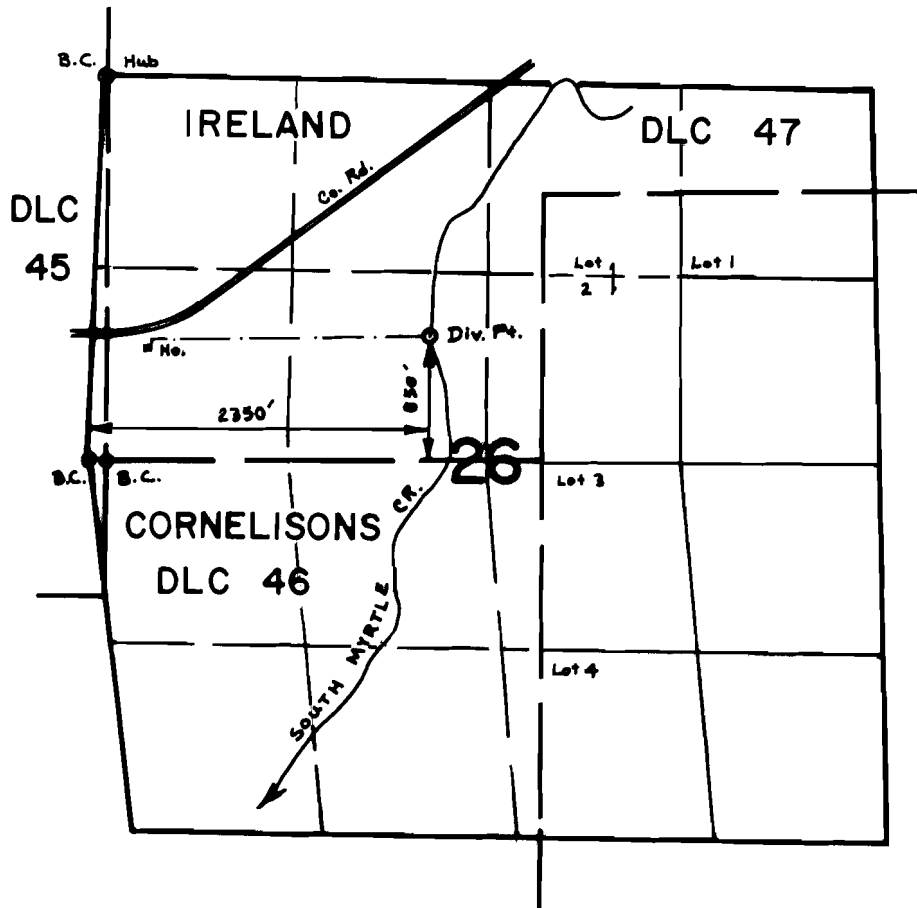

SCALE: 4" = 1 mile

FINAL PROOF SURVEY
UNDER

Application No. 56809 Permit No. 42580
IN NAME OF

WILLIAM L. MITCHELL

Surveyed July 26, 1978, by D. Sparks