


T.29S. R.8W. W.M.

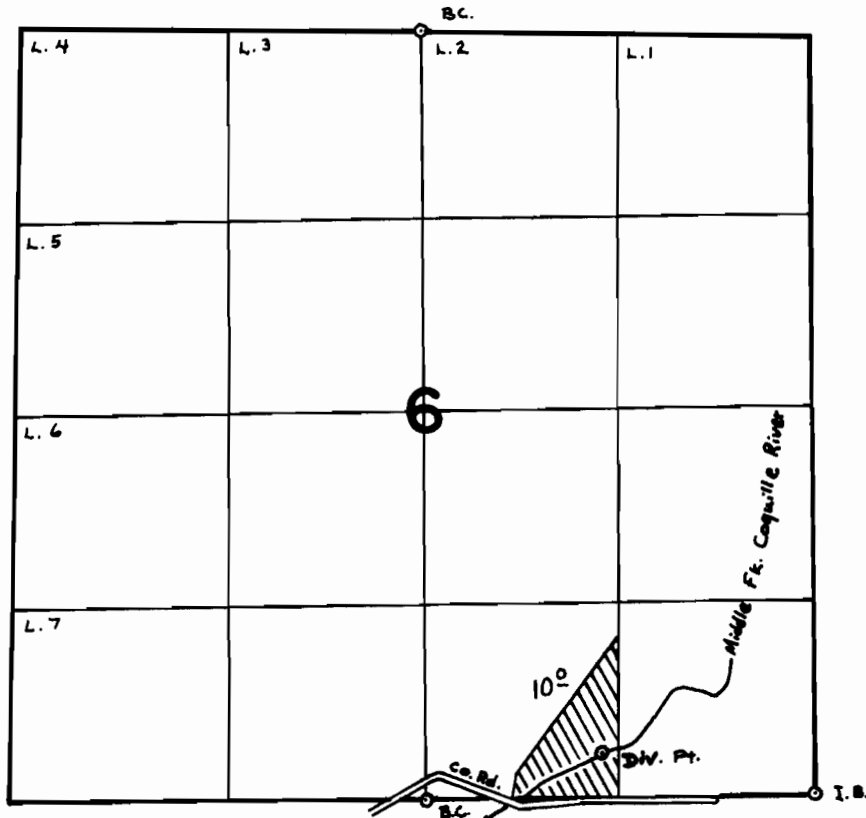

Div. Pt. Located : 300' N & 1220' E from the S $\frac{1}{4}$ corner, Sec. 6

SCALE : 4" = 1 mile

FINAL PROOF INSPECTION
UNDER

Application No. 48664 Permit No. 36496
IN NAME OF

BLANCHE P. STIMMEL

Inspected July 13, 1978 by D. Sparks