


T.25 S., R. 5 W., W.M.

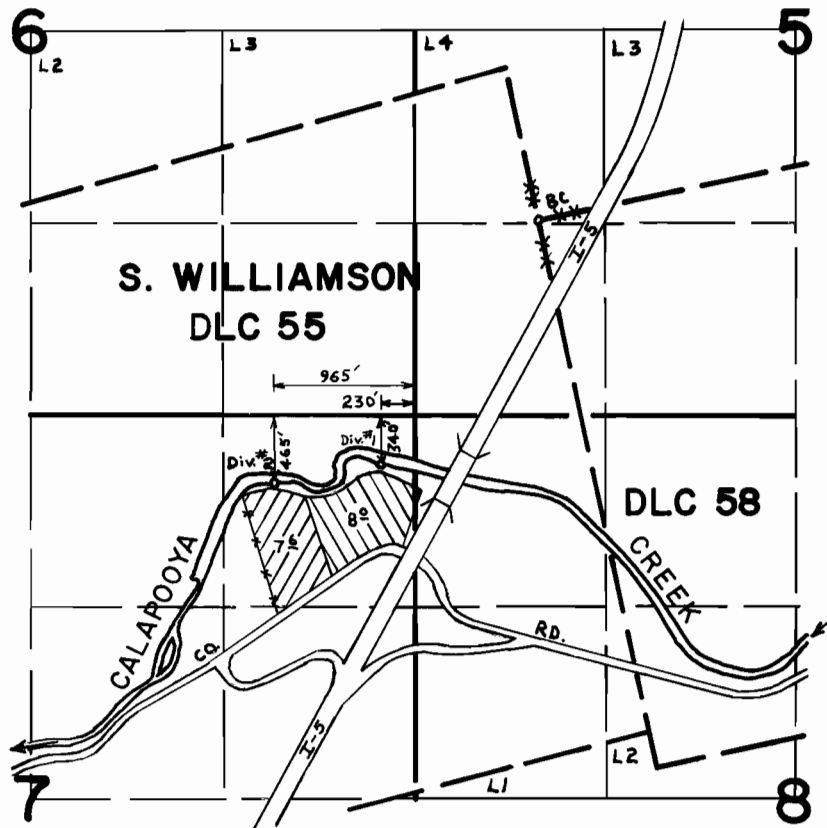

**FINAL PROOF SURVEY**  
UNDER

Application No. 53217 Permit No. 39491  
IN NAME OF

**FRED & JUNE BOZEMAN and DON & EMILY COOKE**

Surveyed SEPT. 18, 1978, by D. B. HENRY.....