


# T. 27 S., R. 6 W., W.M.

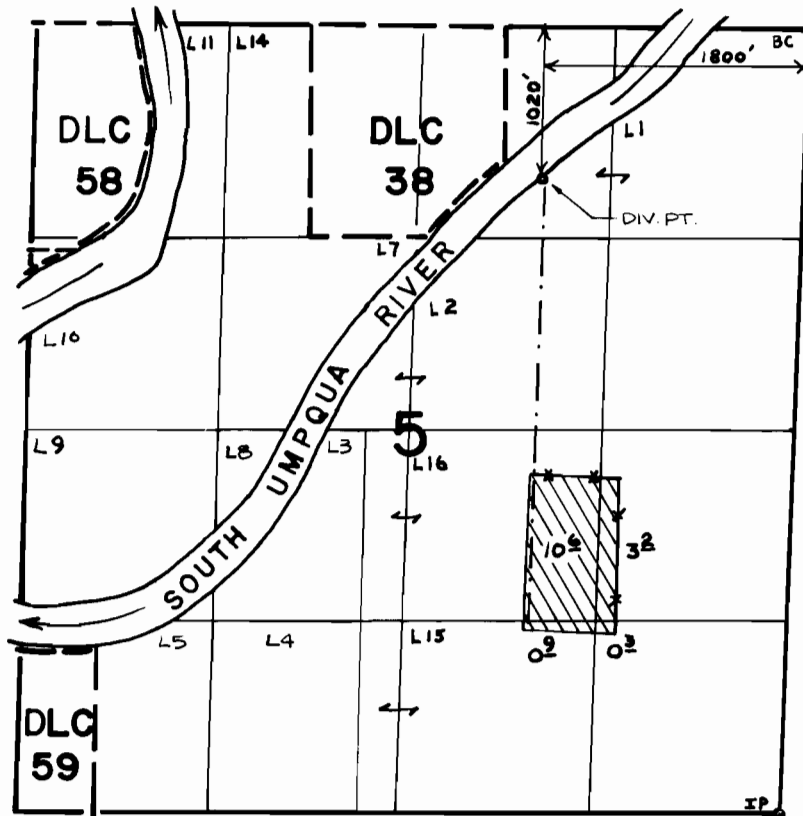

## FINAL PROOF SURVEY UNDER

Application No. 55102... Permit No. 41595...  
IN NAME OF

..... **W. F. BONEBRAKE** .....

Surveyed F.E.B. 9... 1978, by D.W. SPARKS..