


T. 25 S., R. 6 W., W.M.

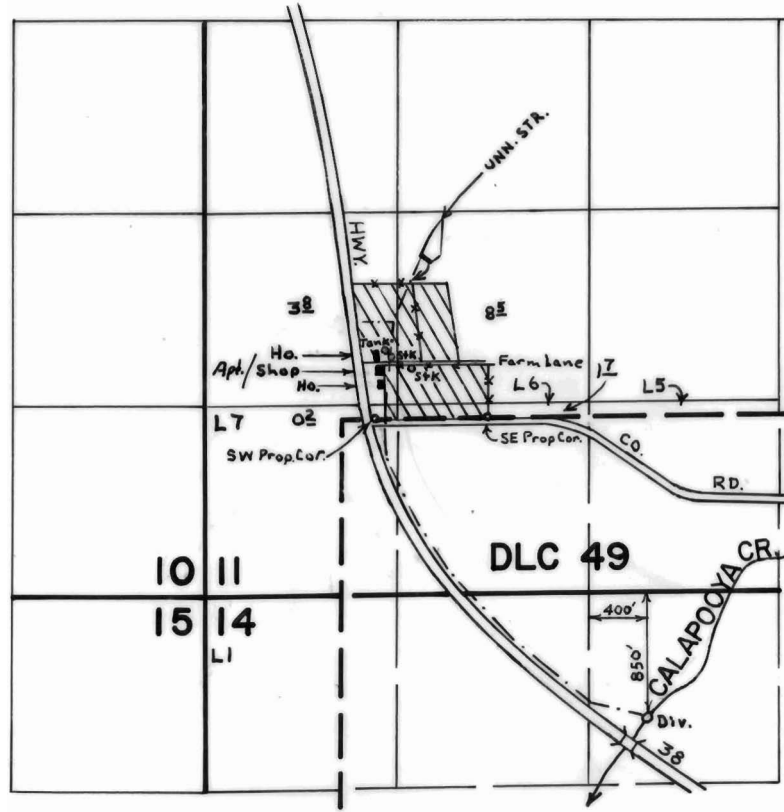

FINAL PROOF SURVEY
UNDER

Application No. 52171... Permit No. 37527...
IN NAME OF

CHARLES C. STEWARD, JR.

Surveyed MAR. 20 1978, by D.W. SPARKS...