


T.27S. R.5W. W.M.

Sec. 14

SW1/4 SW1/4

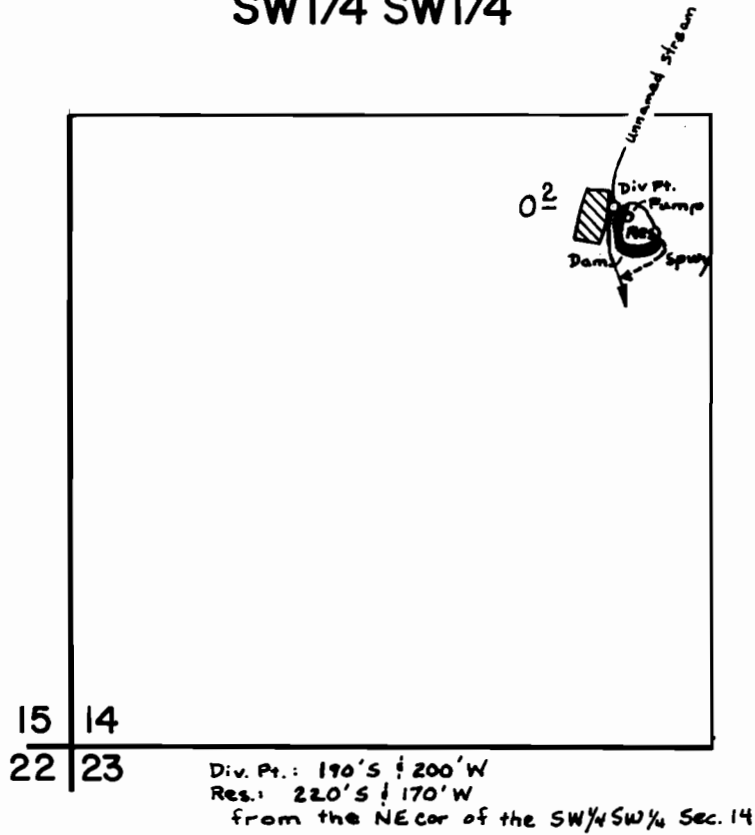

SCALE: 1" = 400'

FINAL PROOF SURVEY
UNDER

R-54856 R-6558
Application No. 54487 Permit No. 41225
IN NAME OF
LAFAYETTE MADDOX

Surveyed April 26, 1978, by D. Sparks