T. 26 & 27 S., R. 6 W., W.M.

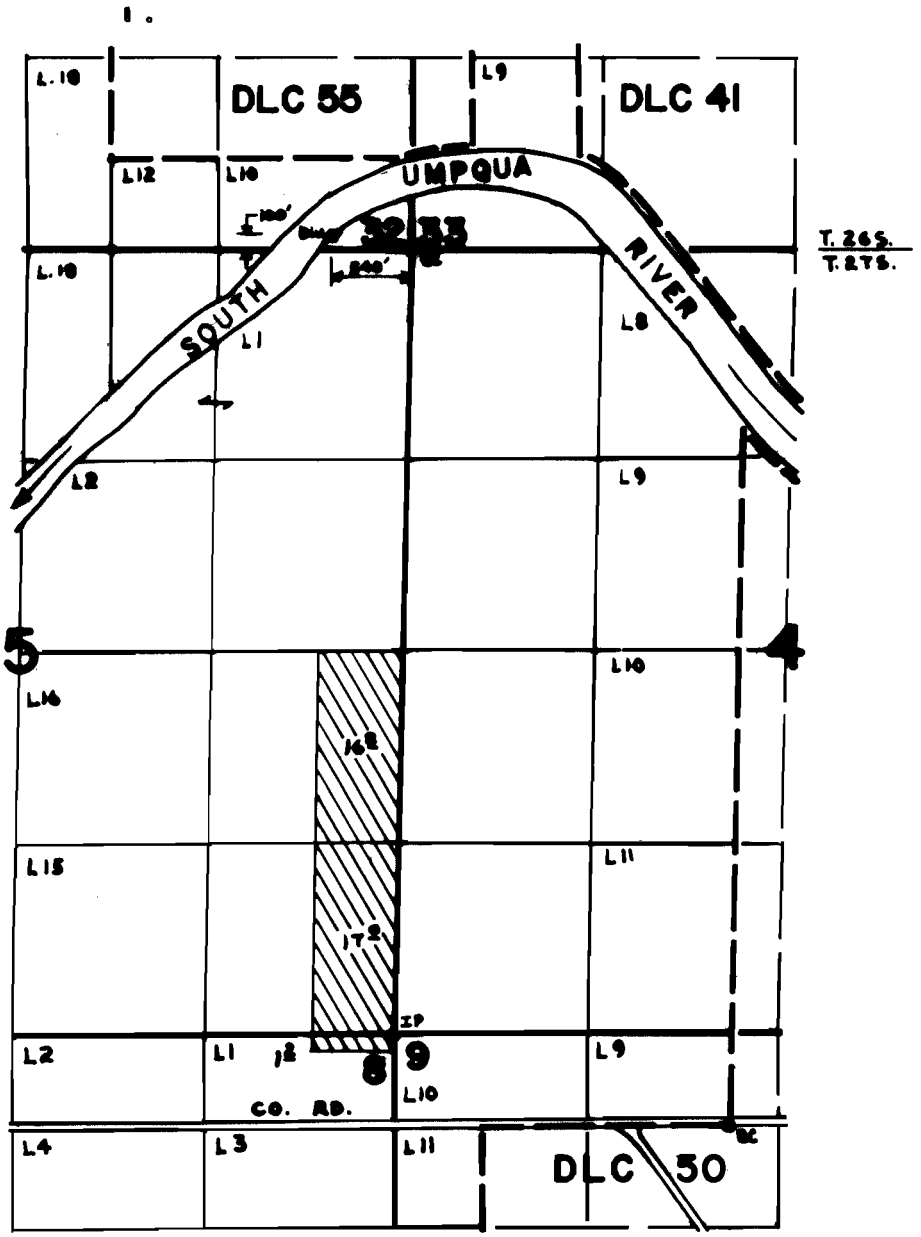

FINAL PROOF SURVEY
UNDER

Application No. 54319 Permit No. 40668
IN NAME OF

DUANE CONN

Surveyed JUNE 26 1978, by D.W. SPARKS

BTR-1HH-120 DRH