


T.27 & 28S. R.6W. W.M.

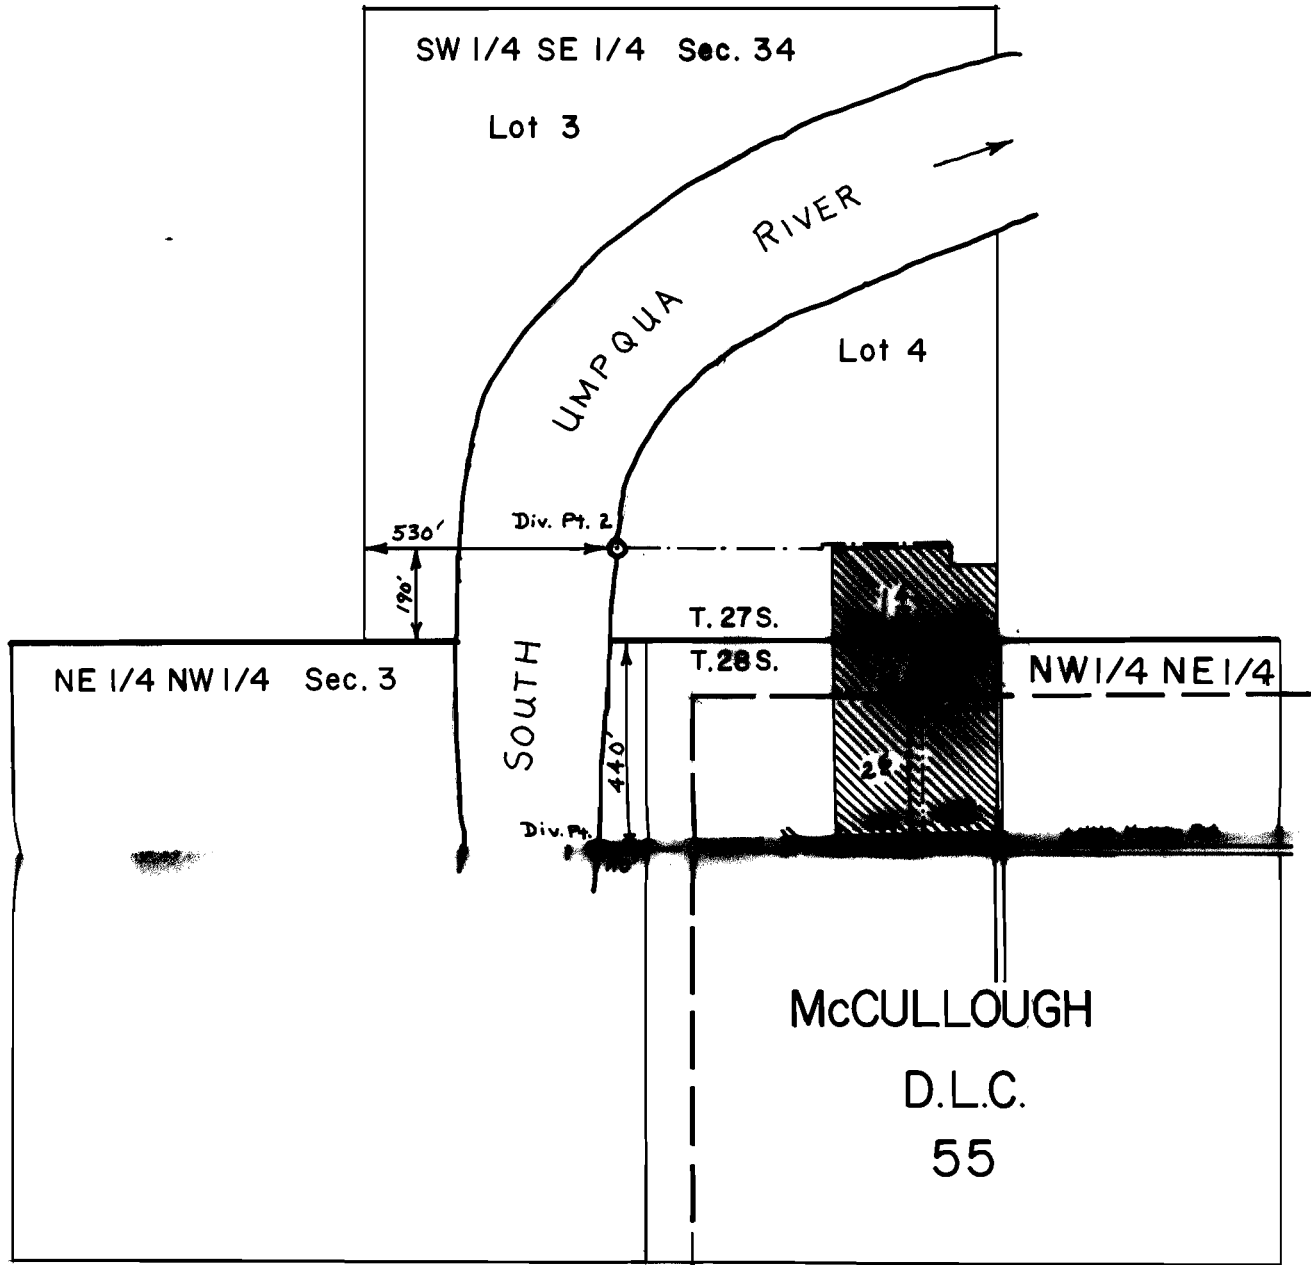

SCALE: 1" = 400'

FINAL PROOF SURVEY
UNDER

Application No. 56645 Permit No. 42445

IN NAME OF

GERALD I. GOUDE

Surveyed Aug. 3, 1978, by D. Sparks