
T.27S., R.7W., W. M.

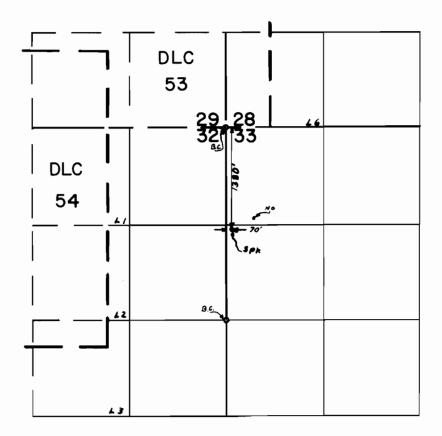

FINAL PROOF SURVEY

Application No513	250 Permit No. 38710
IN NAME OF	
LARRY	C. JACOBS
Surveyed OCT. 18	1977 by D.W. SPARKS