


T.31S. R.7W. W.M.

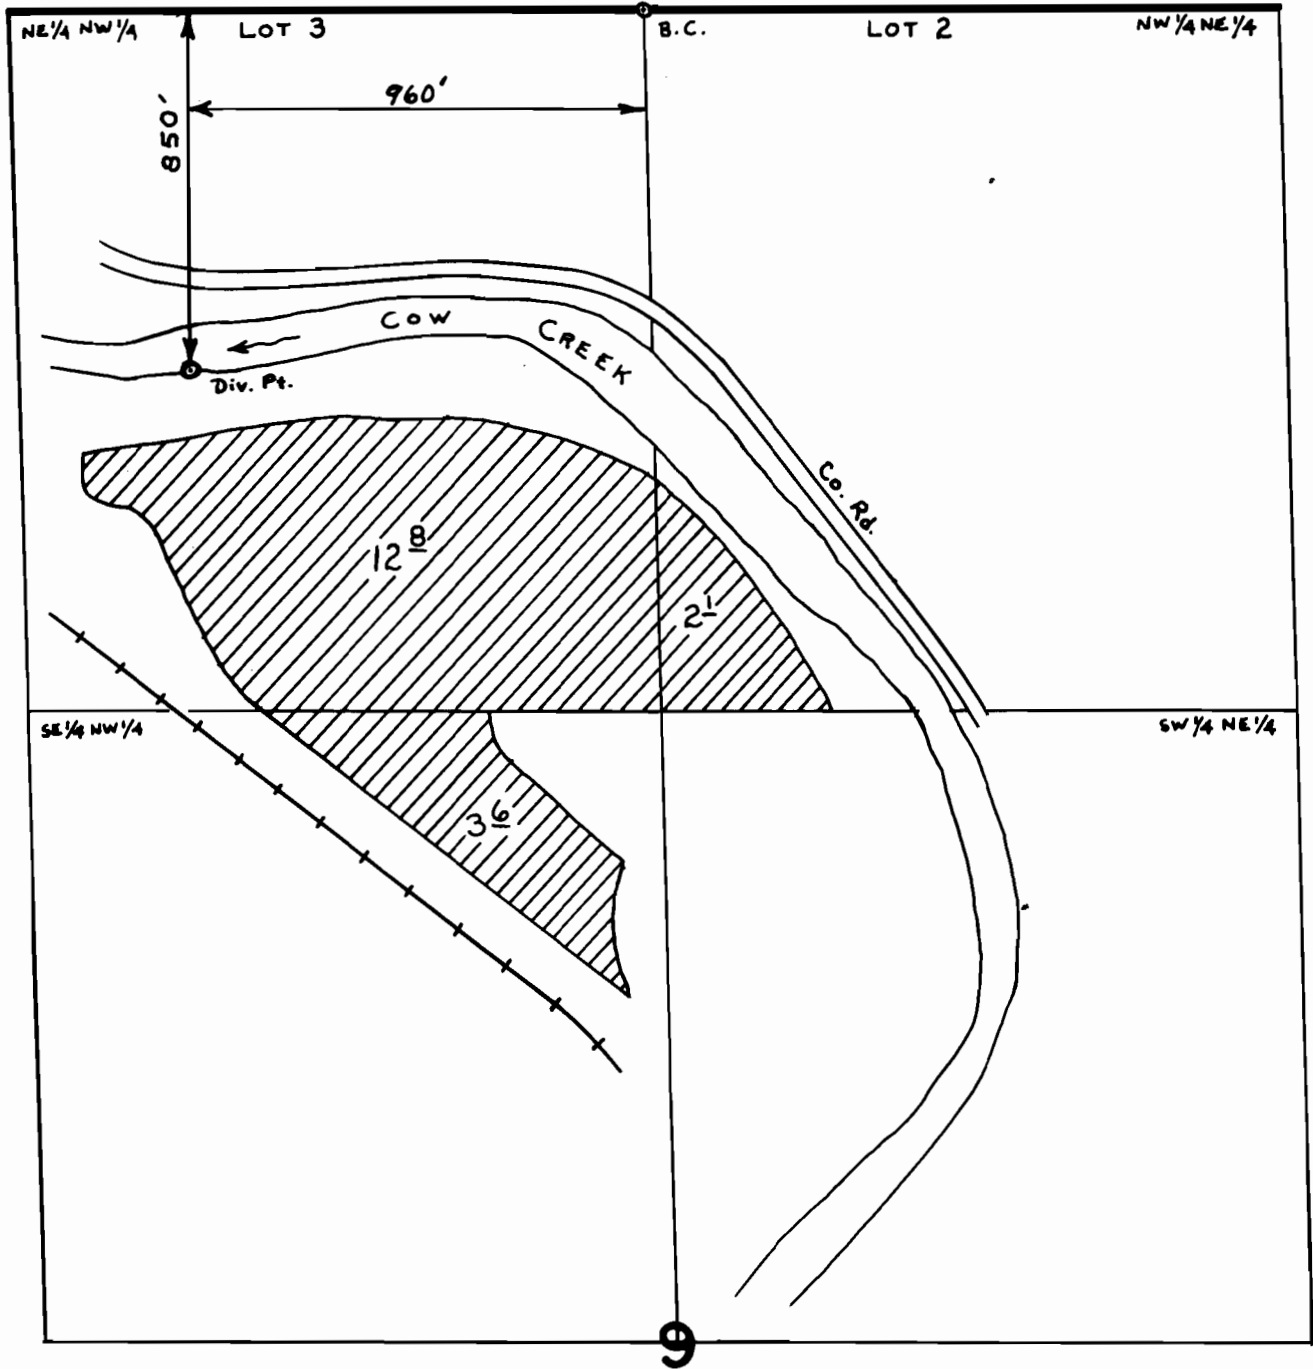

SCALE: 1" = 400'

**FINAL PROOF SURVEY**  
UNDER

Application No. 50879 Permit No. 38418  
IN NAME OF

**PATTI RIEMAN / JAMES M. CHAMBERS**

Surveyed Sept. 26 1978, by D. R. Henry