


T. 26 S., R. 2 W., W.M.

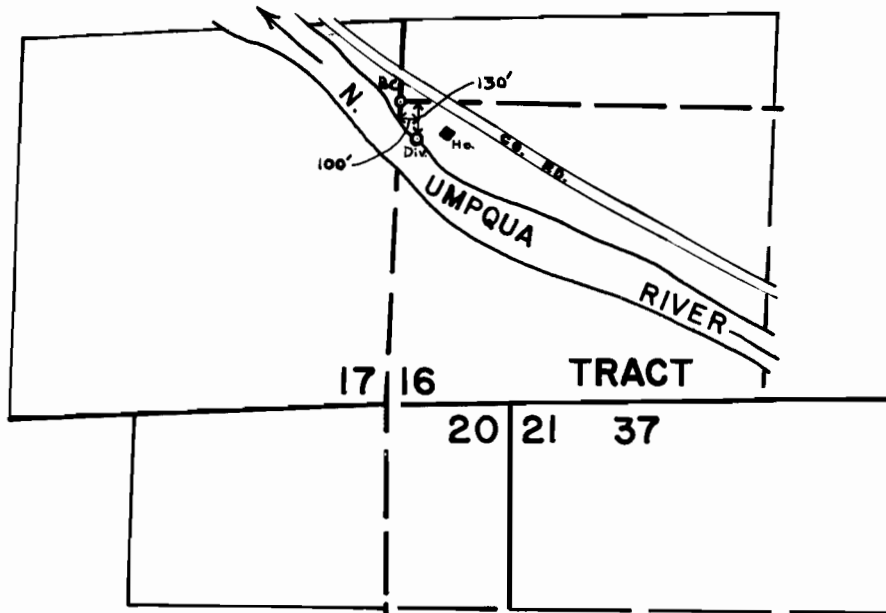

Scale: 1" = 660'

FINAL PROOF SURVEY
UNDER

Application No. 54258 Permit No. 40637
IN NAME OF

RALPH D. BIRDSELL

Surveyed NOV. 16 1977, by D.W. SPARKS