


T. 25 S., R. 6 W., W.M.

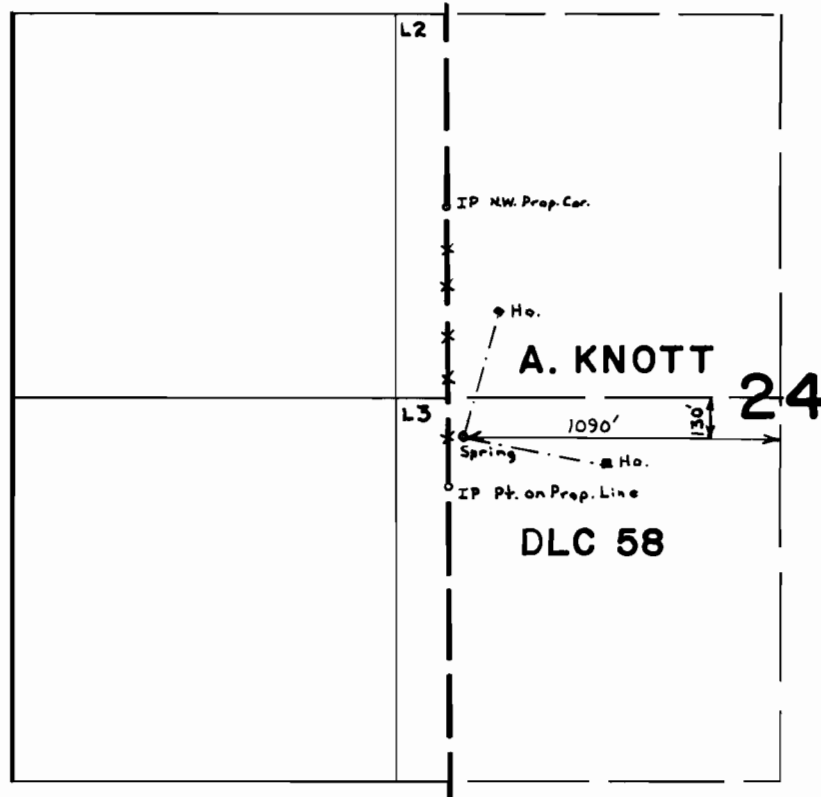

SCALE: 1" = 660'

FINAL PROOF SURVEY
UNDER

Application No. 54259 Permit No. 40638
IN NAME OF

TRACY J. WARD

Surveyed MAY 2 1978, by D.W. SPARKS