


T.I.S.R.21E.W.M.

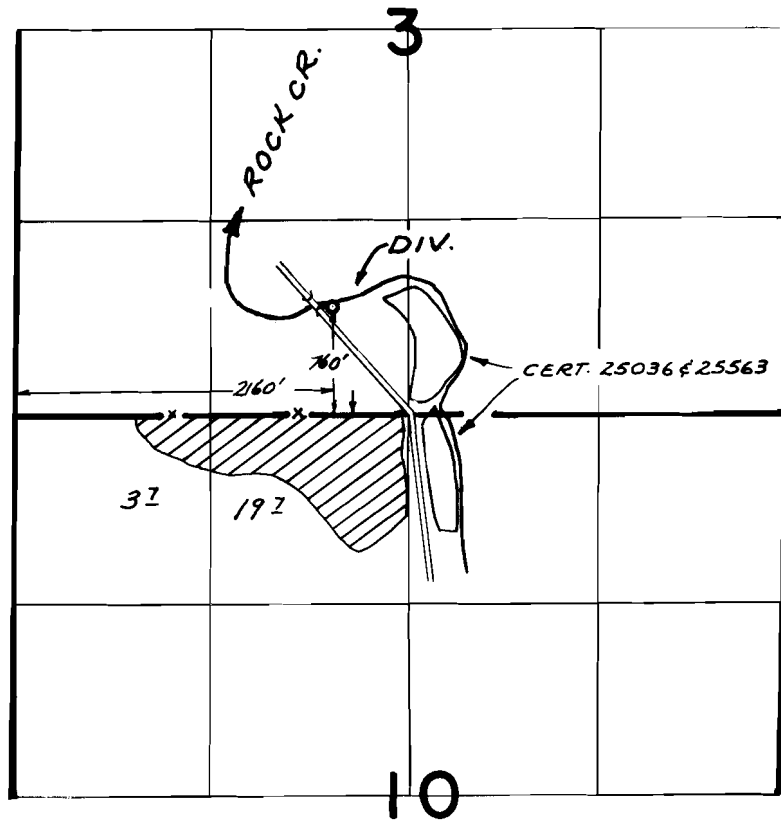

FINAL PROOF SURVEY UNDER

Application No. 53896 Permit No. 40215
IN NAME OF

ROBERT M. IRBY

Surveyed OCT. 25 1977, by R. MUCKEN