


T.32&33S.R.34E.W.M.

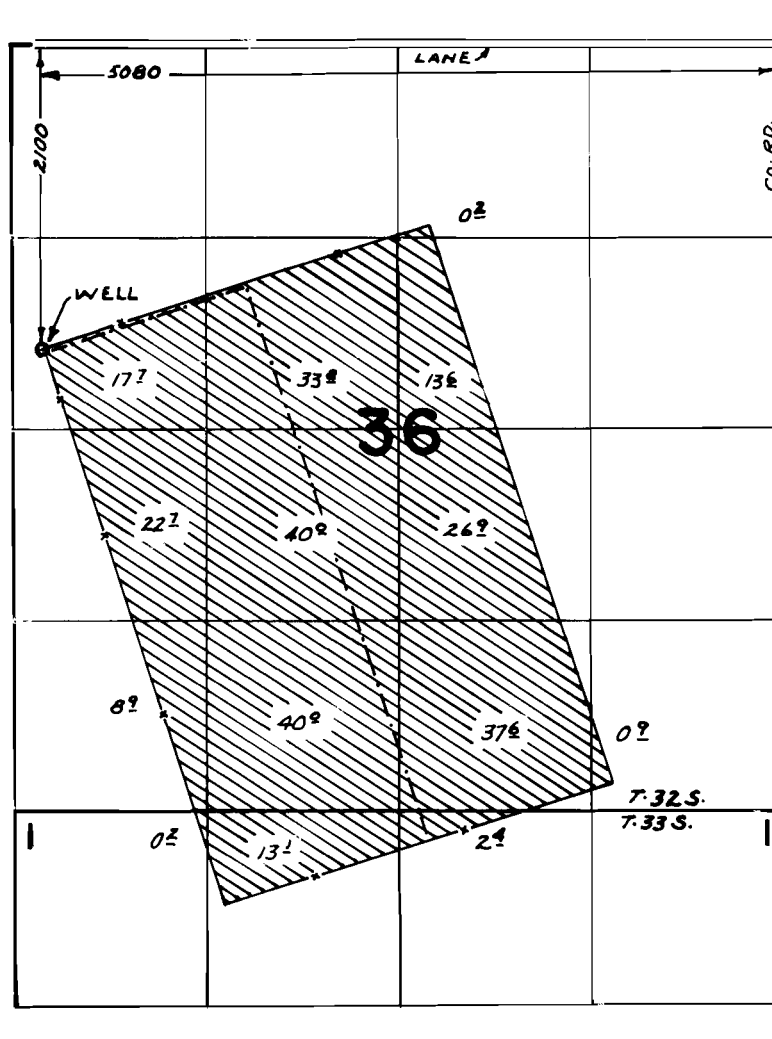

FINAL PROOF SURVEY
UNDER

Application No. G-5075 Permit No. G-4791
IN NAME OF

Constance H. (Wilson) Ickes

Surveyed JUNE 21 1976, by R. MUCKEN