RECEIVED
JAN 5 1979
WATER RESOURCES DEPT.
SALEM, OREGON

T.9S.R.26E.W.M.

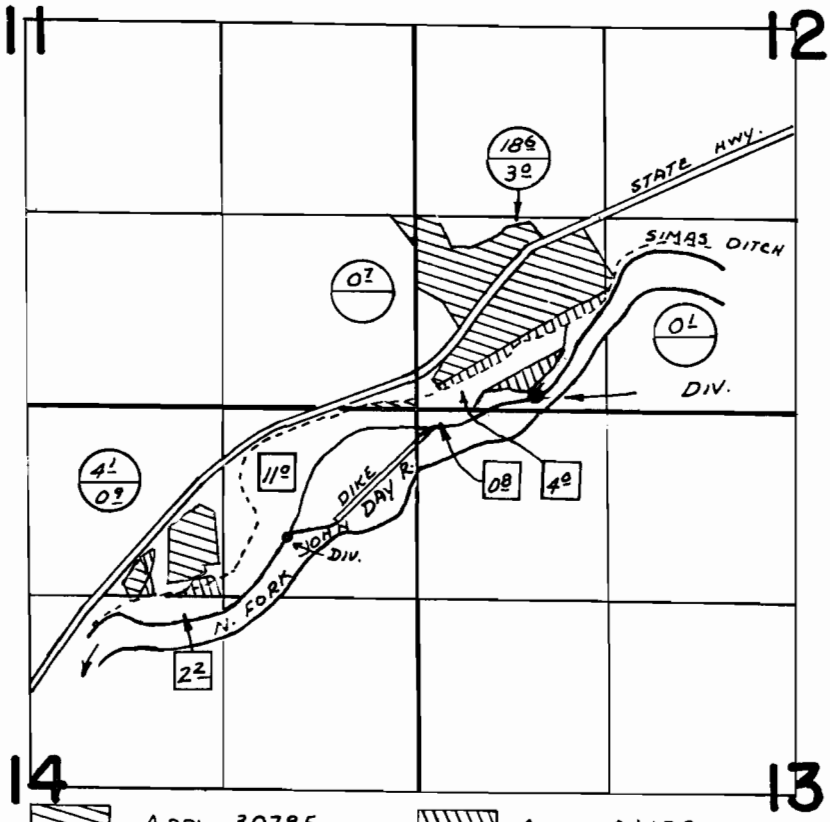

APPL. 30795 APPL. 33132

DIV. PTS. LOC: 90'N. & 800'E & 900' S & 900'W
BOTH FROM S.W. COR. SEC. 12

A-30795
A-33132

IRR. UNDER PERMIT 4036

FINAL PROOF SURVEY
UNDER

Application No. 30795 / 33132 Permit No. 24534 / 26201
IN NAME OF

A. D. FLEMING

Surveyed JULY 15 1957, by R. H. WHITBY
AUG. 22 1961 R. JACKSON
OCT. 16 1972 R. MUCKEN
OCT. 1978 J. RODGERS

R.G.M.