


Section 19

T. 40 S., R. 3 W., W. 1.

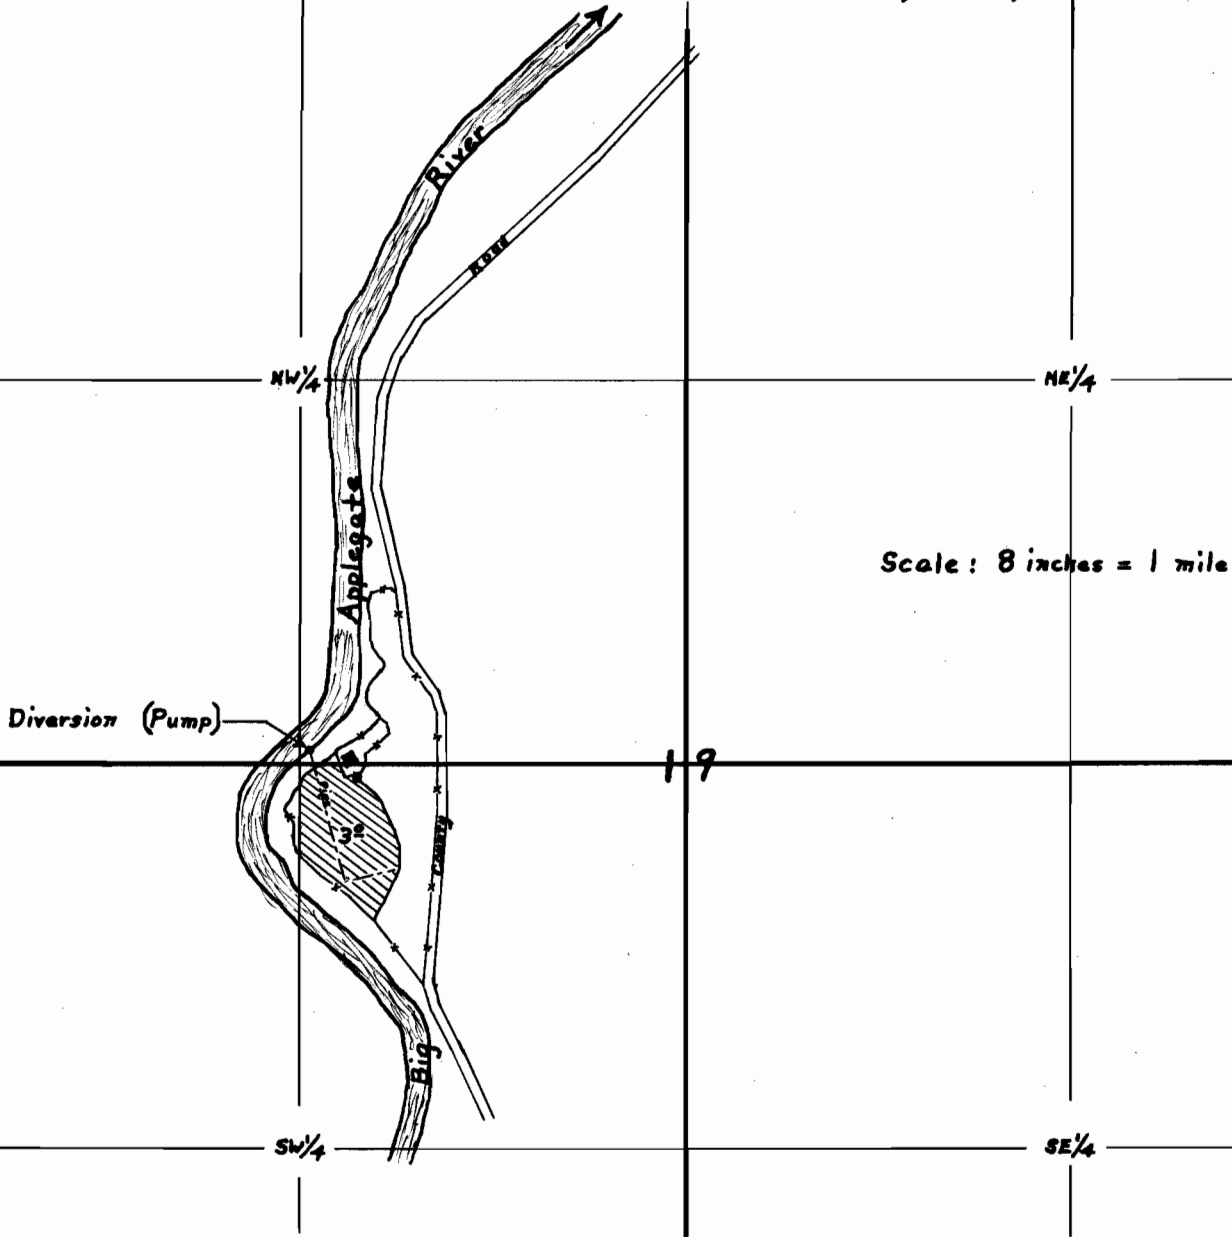

FINAL PROOF SURVEY

UNDER

Application No. 27627 Permit No. 21761

IN NAME OF

Gerald Buck

Surveyed March 16, 1956, by D.C. Hendrix, W.M.

RECEIVED
 16 MAR 28 1956
 STATE ENGINEER
 OREGON