


T.35 S., R.3 W., W.M.

T.35 S., R.4 W., W.M.

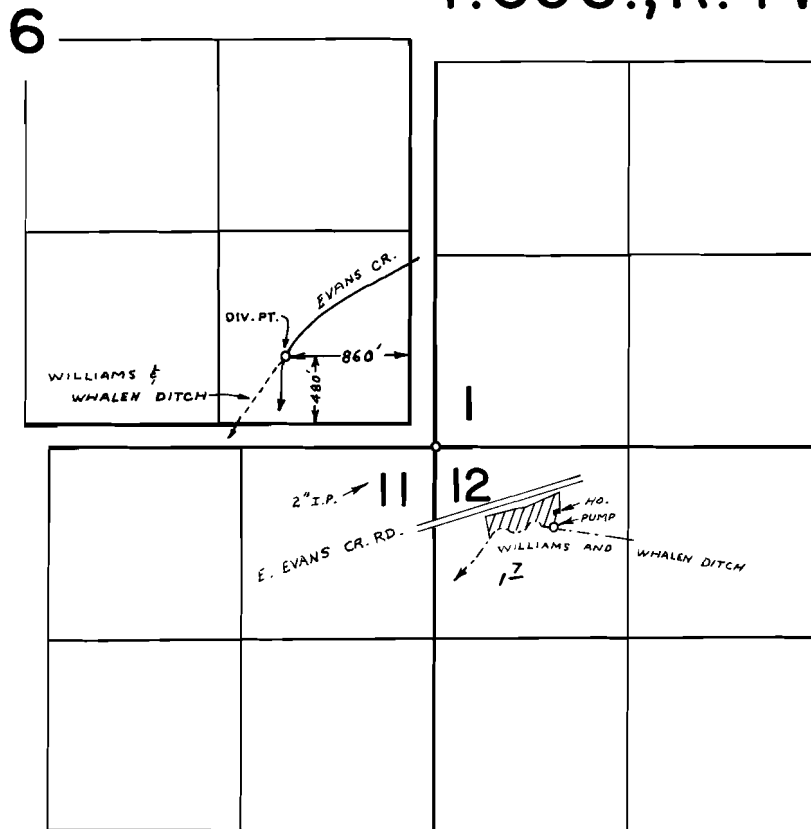

FINAL PROOF SURVEY
UNDER

Application No. 53138 Permit No. 38772
IN NAME OF

ISAIAS &/OR HELEN F. DURAN

Surveyed DEC. 22 1977, by B. SUND