T.35 S., R.3 W., W.M.

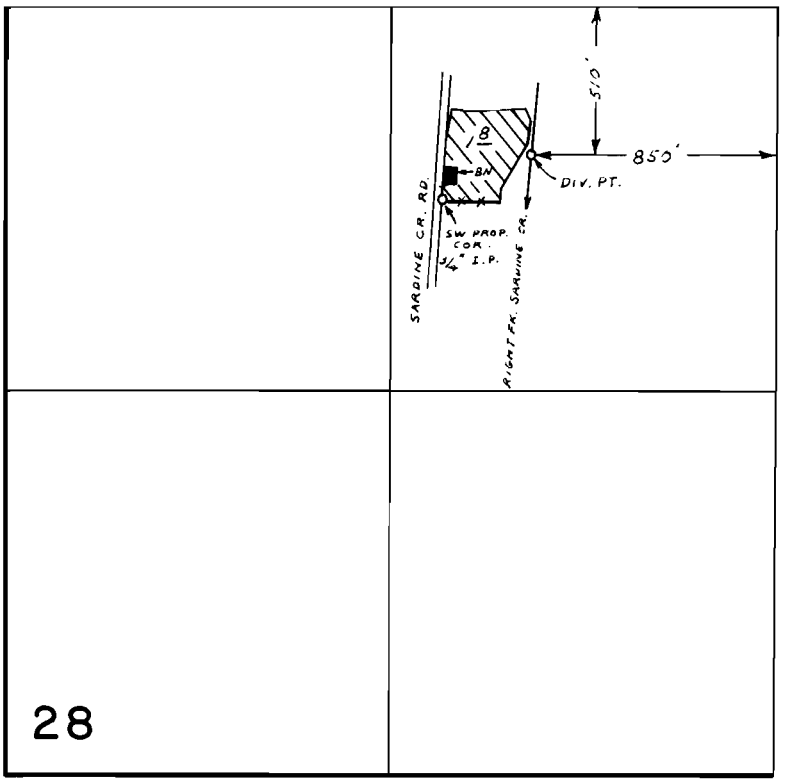

SCALE: 1" = 660 FT.

FINAL PROOF SURVEY
UNDER

Application No. 52153 Permit No. 39278

IN NAME OF

JOHN F. &/OR ESTHER M. EVANS

Surveyed SEPT. 19 1978, by B. SUND

P.T.S. - 1978 - 14 - C