


T.33 S., R.1 E., W.M.

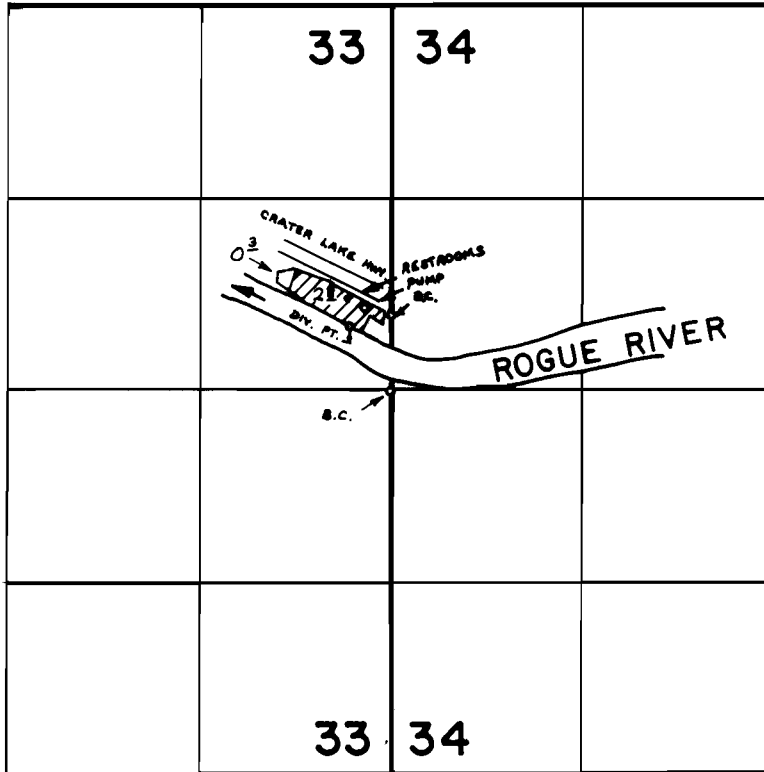

DIV. PT. LOC. - 420' N. & 300' W. FROM E. 1/4 COR., SEC. 33.

FINAL PROOF SURVEY UNDER

Application No. 56598 Permit No. 42546
IN NAME OF

OREGON STATE PARKS & REC. BRANCH

Surveyed AUG. 9 1978, by B. SUND

D.H.M.

P.T.S. - 1978-14-C