


T. 34 S., R. 1 W., W.M.

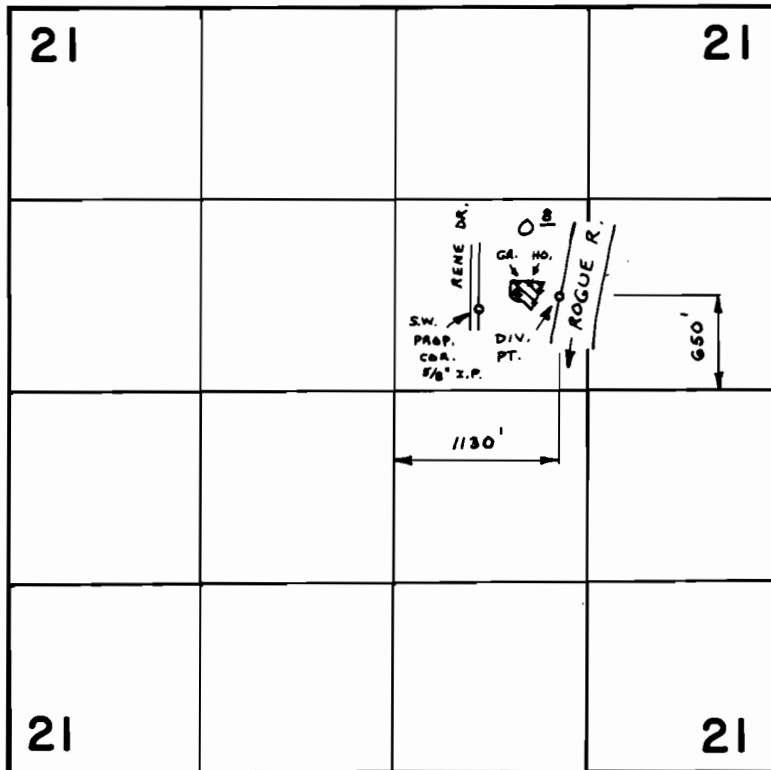

FINAL PROOF SURVEY UNDER

Application No. 47185 Permit No. 35350

IN NAME OF

CAROL J. WINTER

Surveyed OCT. 24 1978, by B. SUND