


T. 38 S., R. 7 W., W.M.

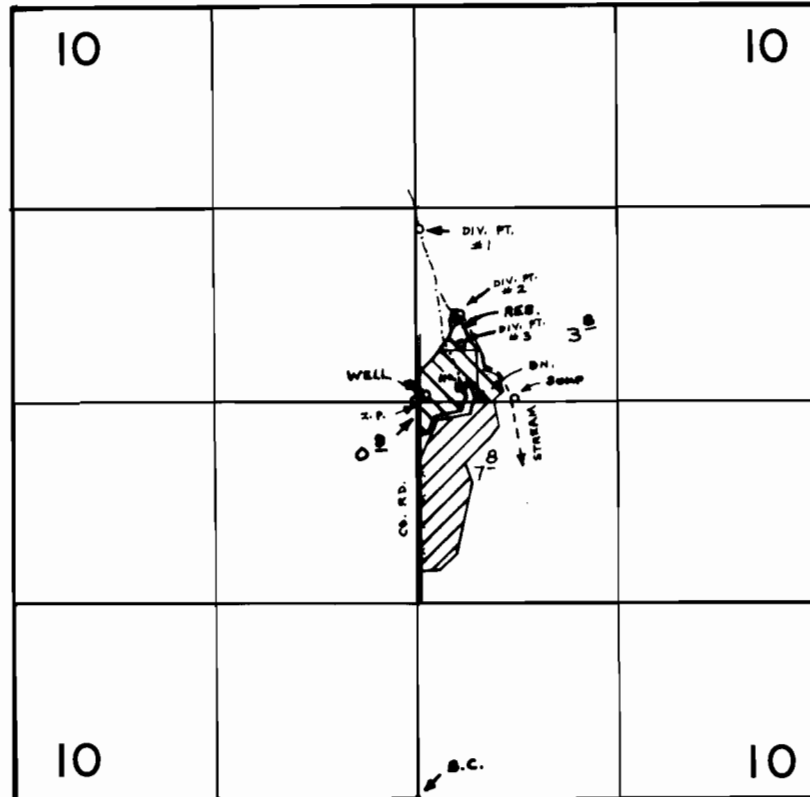

DIV. PT. #1 LOC. - 1200' N. & 30' E., #2 - 600' N. & 300' E., #3 - 400' N. & 310' E., & SUMP - 10' N. & 670' E., ALL FROM CENTER OF SEC. 10.

FINAL PROOF SURVEY

UNDER

G-7411

G-6915

47407

35530

Application No. R-47406 Permit No. R-5713

IN NAME OF

EARLE A. JACKSON

Surveyed SEPT. 29 1977, by B. SUND

