


T21S. R3W. WM.

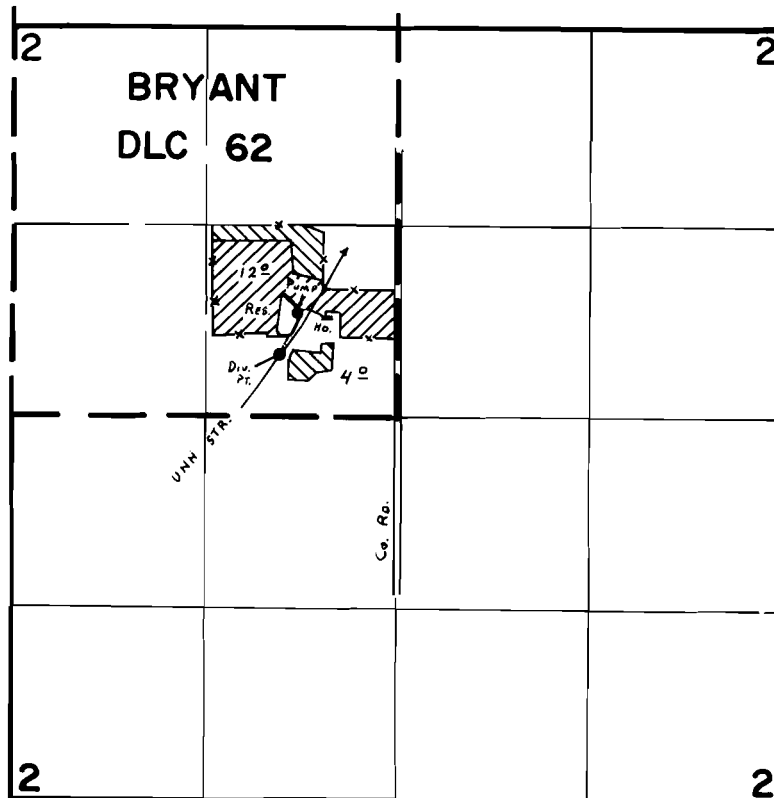

Div. Pt. Loc: 420' N. & 800' W. fr. S.E. Cor. DLC 62.

▨ - PRIMARY IRRIGATION

▨ - SUPPLEMENTAL IRRIGATION

FINAL PROOF SURVEY
UNDER

Application No. R-55142 55631 Permit No. R-6606 41680
IN NAME OF

BOB DENNIS

Surveyed Sept. 10, 1979, by C. L. HUGHES