T.10S.,R.2W.,W.M.

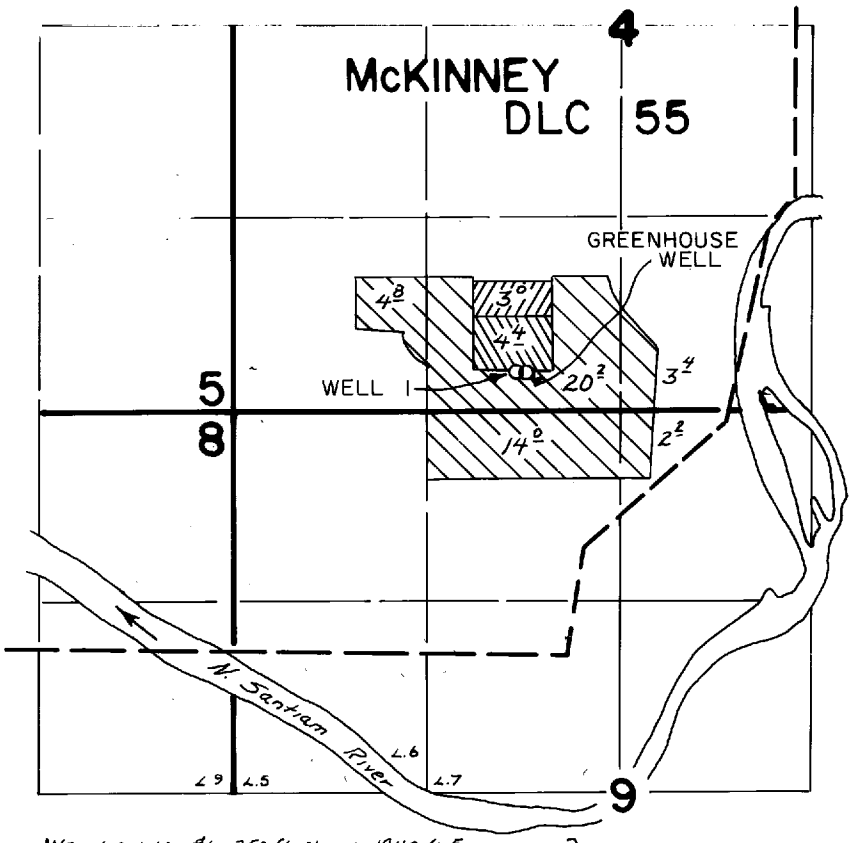

WELL LOC: WELL #1 - 250 ft. N AND 1940 ft E
GREENHOUSE WELL - 250 ft N AND 2000 ft E } BOTH FROM SW COR. SEC. 4

FINAL PROOF SURVEY
UNDER

G-6418 G-7930

Application No. G-6419 Permit No. G-7931

- IRRIGATION AND TEMPERATURE CONTROL
- IRRIGATION AND TEMPERATURE CONTROL
- IRRIGATION ONLY

IN NAME OF

WEYERHAEUSER COMPANY

Surveyed JULY 5 1978, by S.P. APPLEGATE

DFM-6LL-230 LMT