


T.10S., R.2W., W.M.

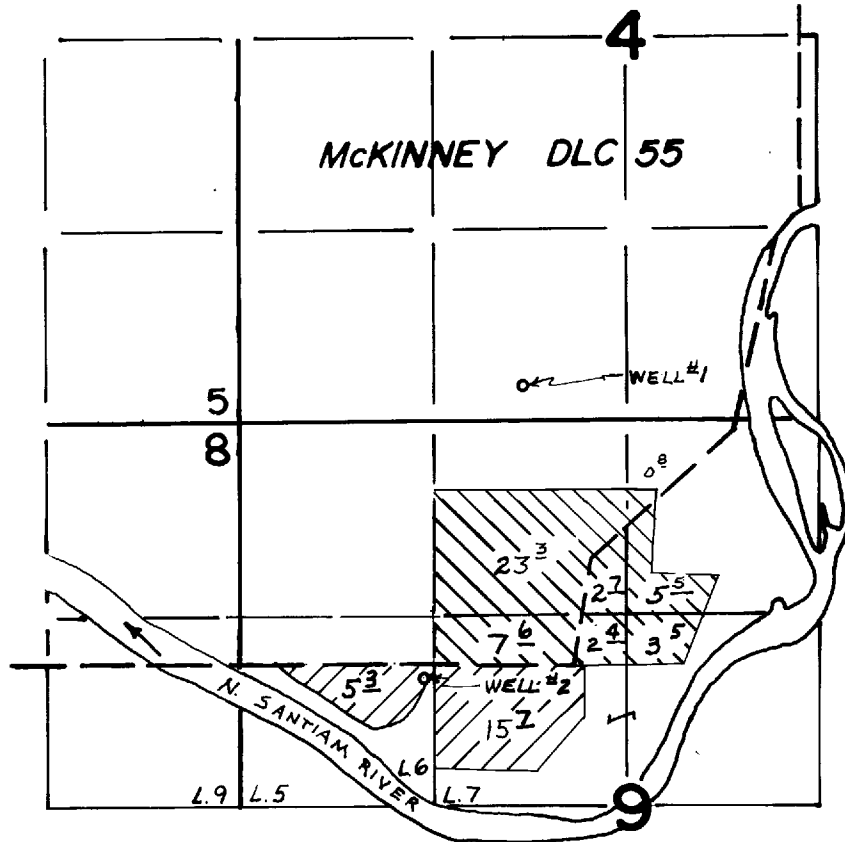

DIV. PT. LOC.: {WELL #1, 250' N. & 1940' E.} BOTH
 {WELL #2, 1760' S. & 1250' E.} FROM N.W. COR. SEC. 9

FINAL PROOF SURVEY UNDER

Application No. G-6420.. Permit No. G-7932..
 IN NAME OF

WEYERHAEUSER COMPANY

Surveyed July 5, 1978, by S.P. APPLIGATE

