


T.9S. R.4W. W.M.

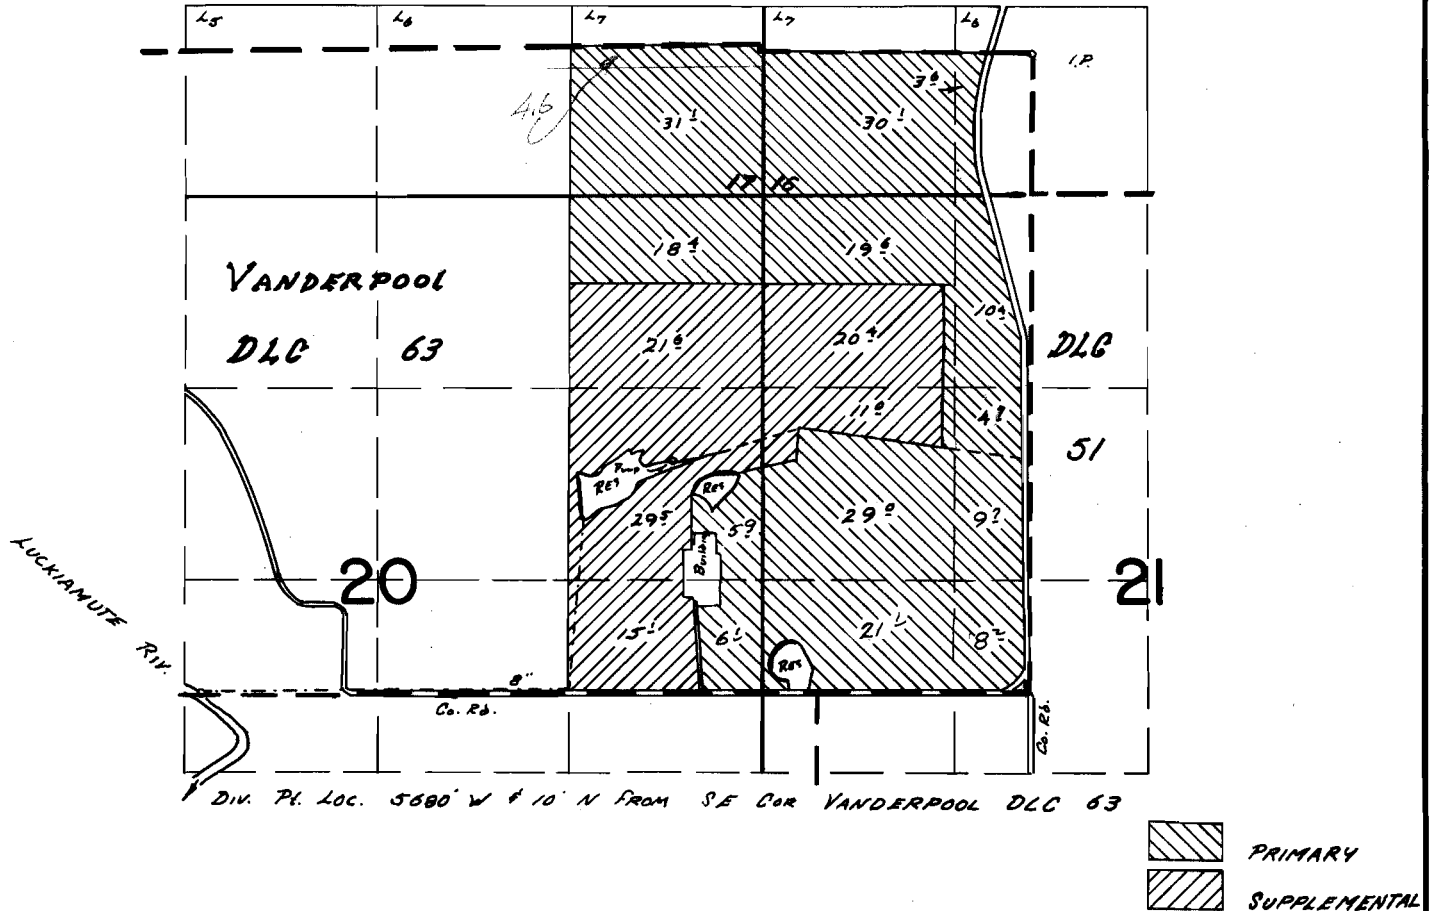

FINAL PROOF SURVEY UNDER

Application No. 4831B Permit No. 35334
IN NAME OF

PATRICK A. OGLE

Surveyed MAY 13 1974 by T. J. POWI