


T. 7S. R. 3W. W.M.

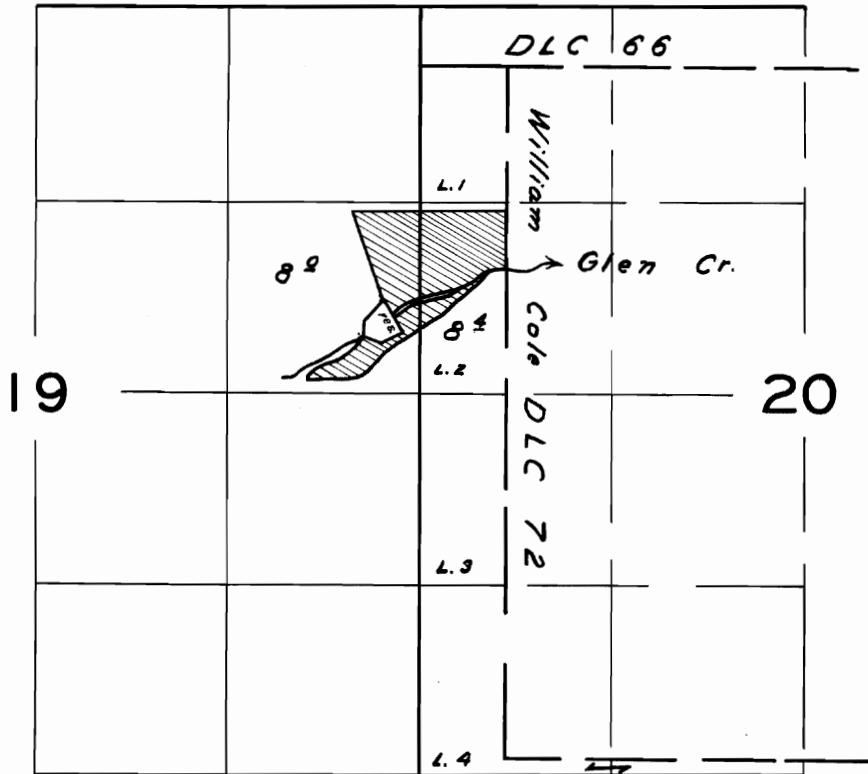

FINAL PROOF SURVEY
UNDER

R-29606 R-1698
Application No. 29607 Permit No. 23310
IN NAME OF

T. L. Shipler

Surveyed July 28 1958, by *W. N. Perry*