


# T. IS. R. 33E. W.M.

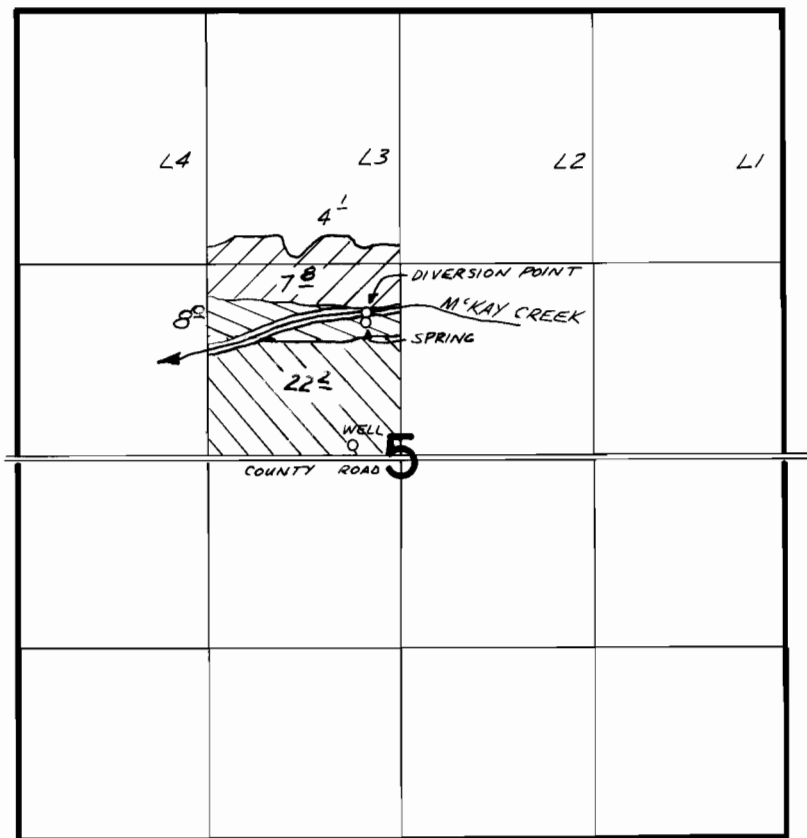

WELL LOCATED 0' N. & 320' W. FROM SE COR SE 1/4 NW 1/4 SEC 5  
 SPRING LOCATED 910' N. & 230' W. FROM SE COR SE 1/4 NW 1/4 SEC 5  
 DIVERSION POINT LOCATED 980' N. & 250' W. FROM SE COR SE 1/4 NW 1/4 SEC 5

## FINAL PROOF SURVEY UNDER

TRANSFER 5-156  
 44465 33258

Application No. G-6742 Permit No. G-6267  
 IN NAME OF

**RICHARD V. & JANIECE H. STANHOPE**

Surveyed OCT 5 1977, by R. BARWIN  
 MAR 30 78

PRIMARY



SUPPLEMENTAL

