


T. IS. R. 3 W. W. M.

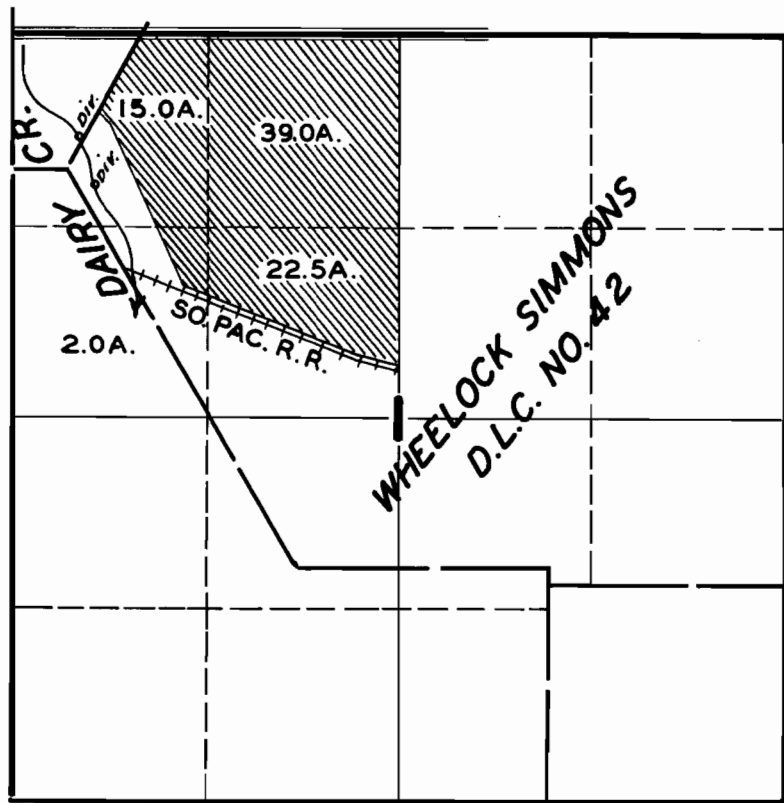

FINAL PROOF SURVEY

UNDER

Application No. 18415 Permit No. 14050

IN NAME OF

EVA BAILEY LYNCH

Surveyed JUNE 1, 1948, by JAS. E. BUNNELL