


# T. 7S. R. 38E., W.M.

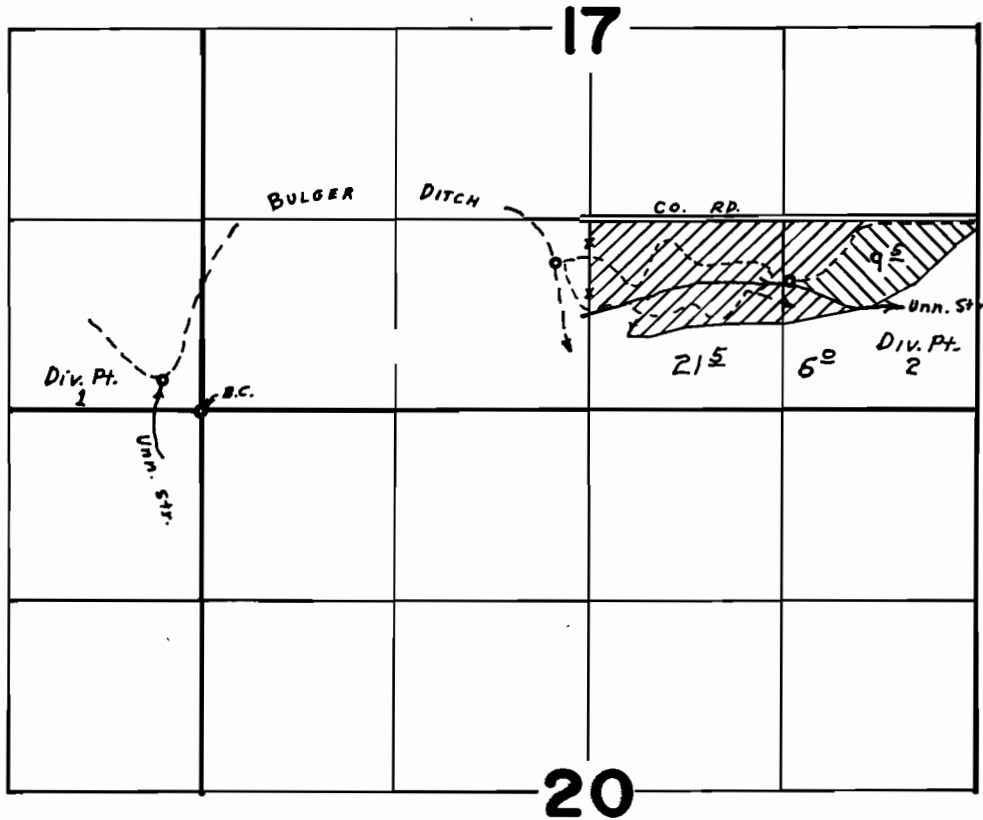

Div. 1 Loc. 200' N. & 270' W. Both From S.W. Cor. Sec. 17  
 Div. 2 Loc. 890' N. & 400' E.

## FINAL PROOF SURVEY UNDER

Application No. 42660 31882  
 42742 Permit No. 31924  
 IN NAME OF

*David V. Mechau*

Surveyed MAY 18, 1970, by L. E. GOULD  
 JULY 26, 1979 - V. CHURCH & D. JARRETT