


T.IIS. R.7W. W.M.

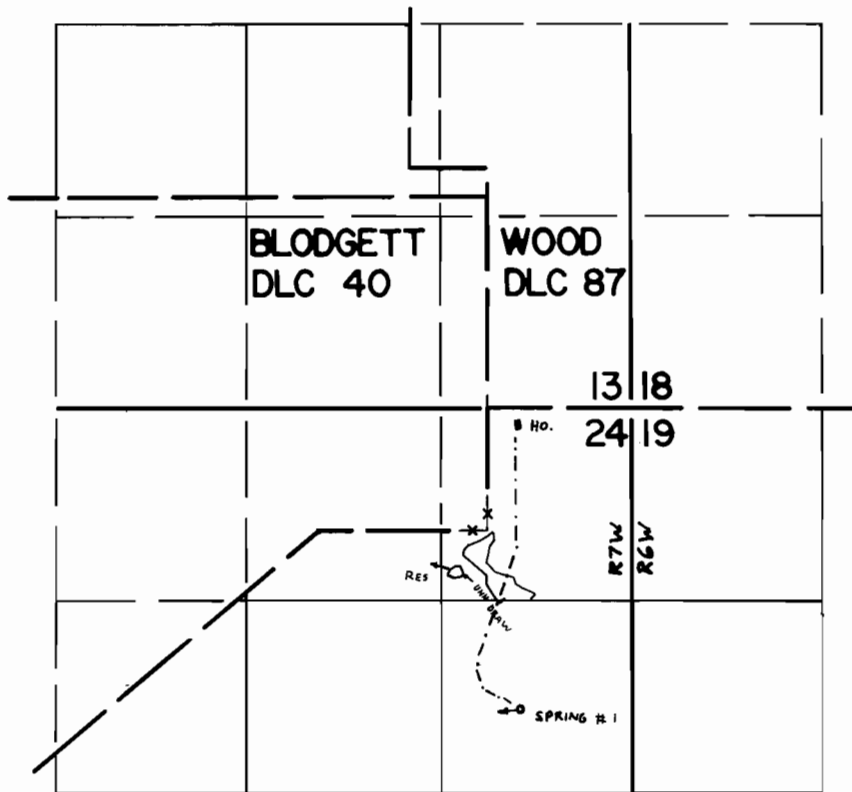

SPR. Loc: 1220'S. & 230'E. fr. most EASTERLY S.E. COR. D.L.C. 40.

FINAL PROOF SURVEY

UNDER

Application No. R-49462 Permit No. R-6018
49463 37051
 IN NAME OF

ARNOLD P. SECHER.

Surveyed APRIL 28 1977, by LARRY TOLL
MAY 3 1979, C. L. HUGHES