


T.11S. R.7W. W.M.

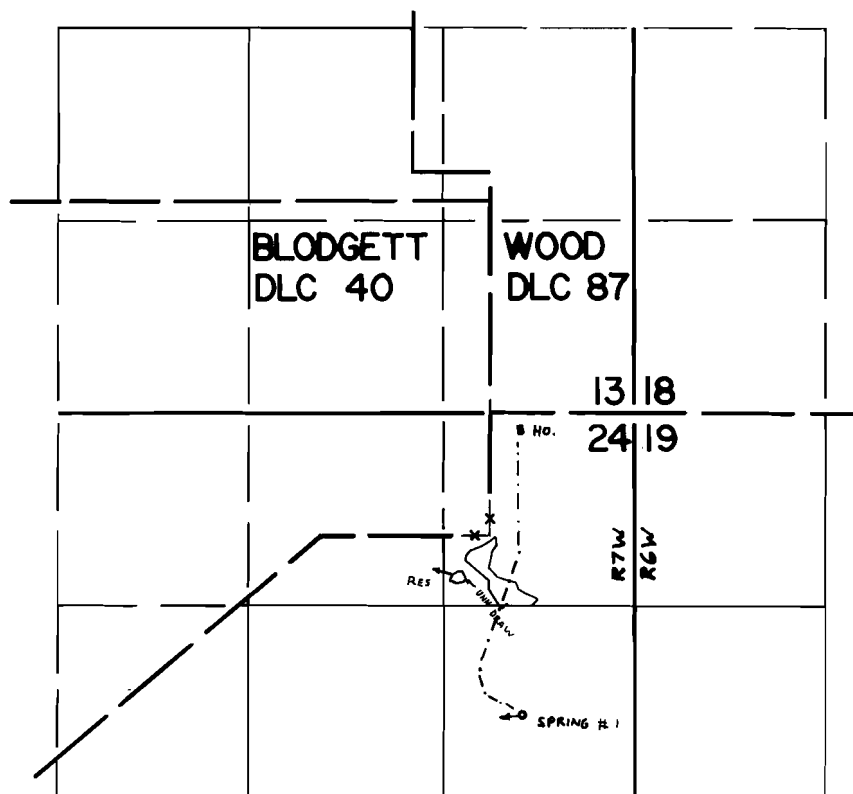

SPR. LOC: 1220'S. & 230'E. fr. most EASTERLY S.E. COR. D.L.C. 40.

FINAL PROOF SURVEY
UNDER

R-49462 R-6018
Application No. 49463 Permit No. 37051
IN NAME OF

ARNOLD P. SECHER

Surveyed APRIL 28 1977, by LARRY TOLL
MAY 3 1979, C. L. HUGHES