


T.8N.,R.7W.,W.M.

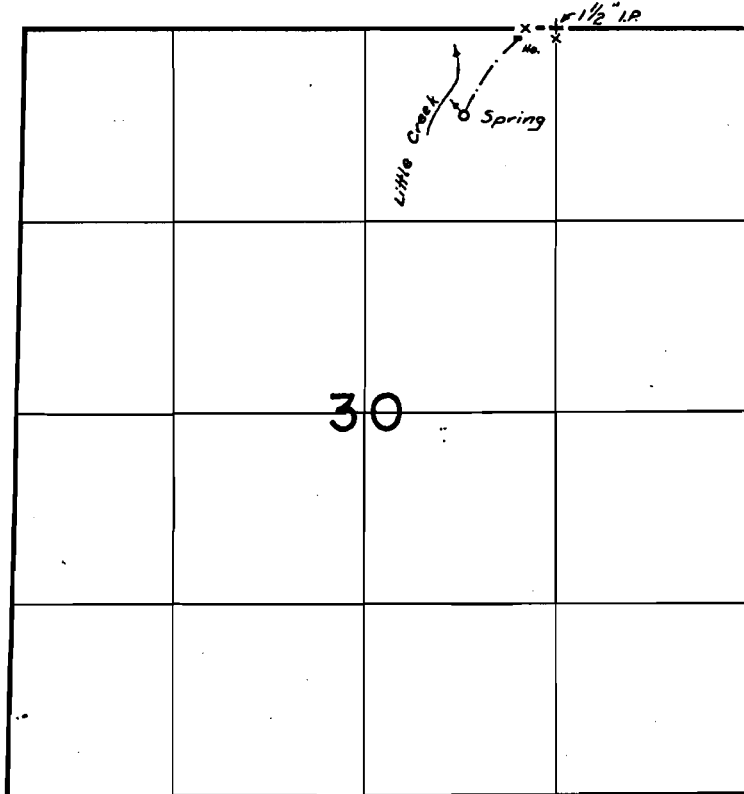

Spring Loc.: 690' S. & 630' W. from NE cor. of NW 1/4 NE 1/4 Sec. 30

FINAL PROOF SURVEY UNDER

Application No. 50018 Permit No. 37607
IN NAME OF

Asa M. & Betty J. Middleton

Surveyed Aug. 3, 1977, by AC Brown