T. 24 & 25S. R. 13W. W.M.

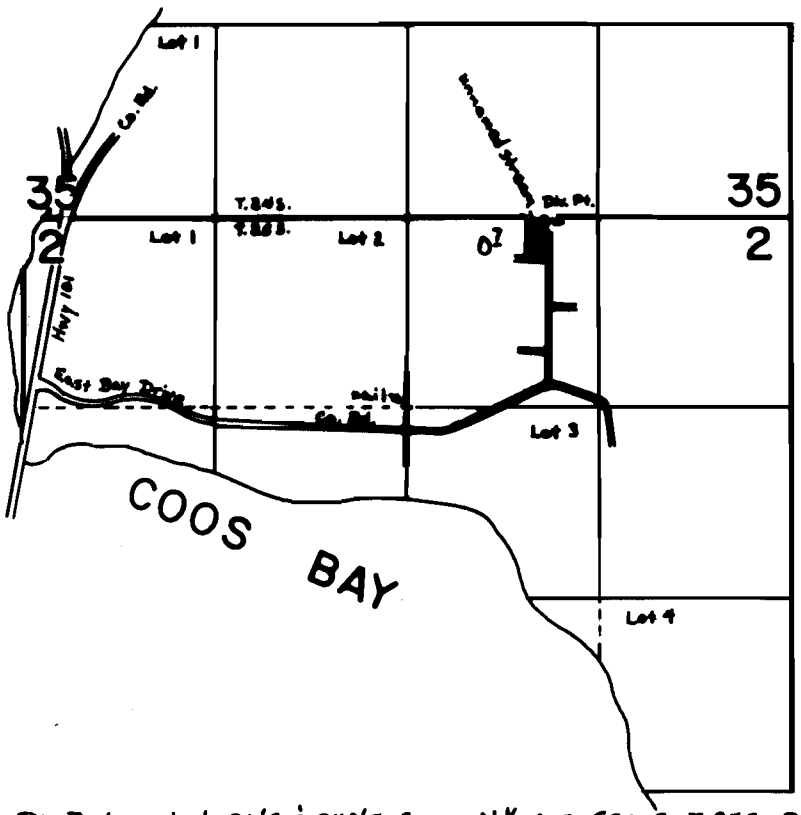

Div. Pt. Located: 30'S & 940'E from N¼ cor. Sec. 2, T. 25S. R. 13 W. W.M.

SCALE: 4" = 1 mile

FINAL PROOF SURVEY
UNDER

Application No. 55647 Permit No. 41687
IN NAME OF

HOWARD C. BARNES

Surveyed Nov. 15. 1978., by S. Donaldson

COB-3HH-19