T. 28S. R.4W. W.M.

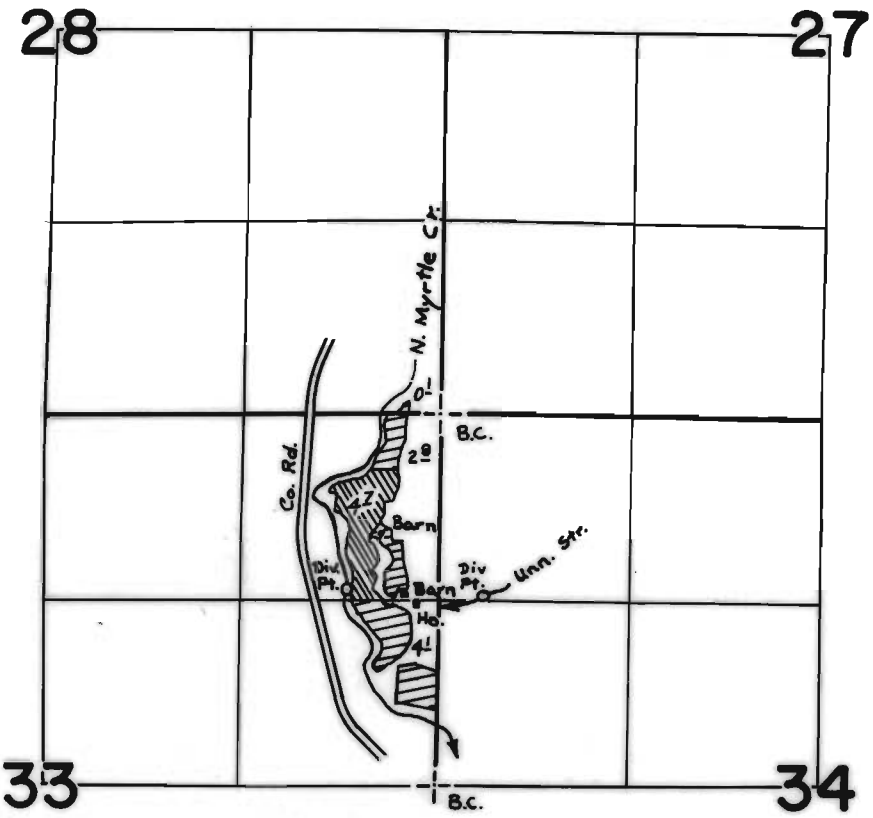

Div. Pts. Located: N. Myrtle Cr. - 1210'S & 630'W from the NE cor. of Sec. 33
Unn. Str. - 1250'S & 300' E from the NW cor. of Sec. 34

Permit # 3458

Permit # 38450

SCALE: 4" = 1 MILE

FINAL PROOF SURVEY
UNDER

Application No. 50928 Permit No. 38450
IN NAME OF

ROBERT JAMES McCREARY

Surveyed Nov. 9 1978, by S. Donaldson

DougCo 77-7-22 ASD