


T.25S., R.7W., W.M.

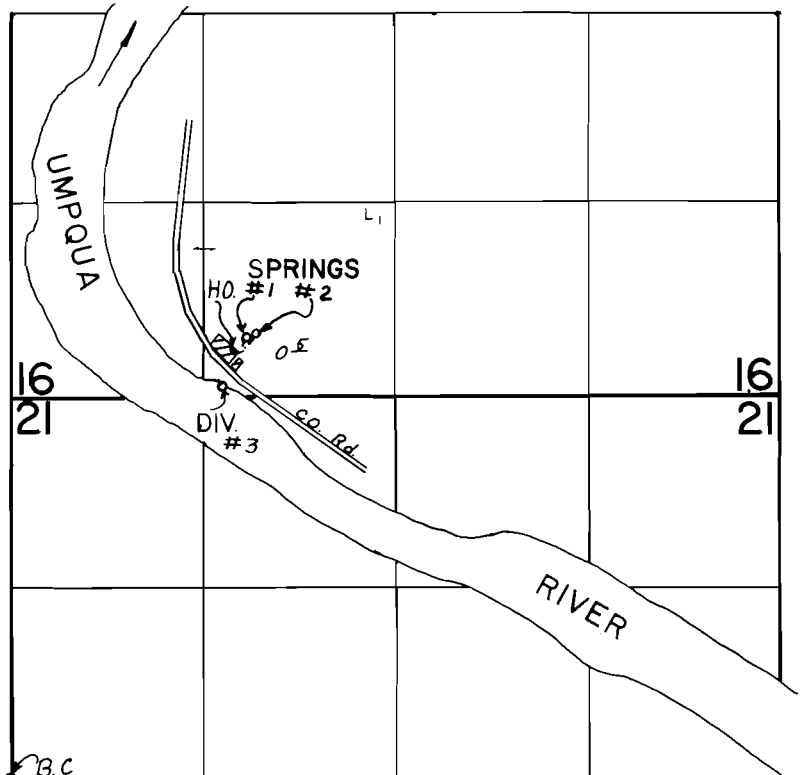

DIV. PTS. LOC: # 1-390' N. & 1620' E., # 2- 410' N. & 1685' E.,
3- 50' N. & 1460' E., ALL FROM THE S.W. COR. SEC. 16

FINAL PROOF SURVEY
UNDER

Application No. 52147 Permit No. 39273
IN NAME OF

HARRY R. & MAVIS E. CONNELL

Surveyed NOV. 2 1977, by D.W. SPARKS