


T. 26 S., R. 4 W., W.M.

SEC. 18

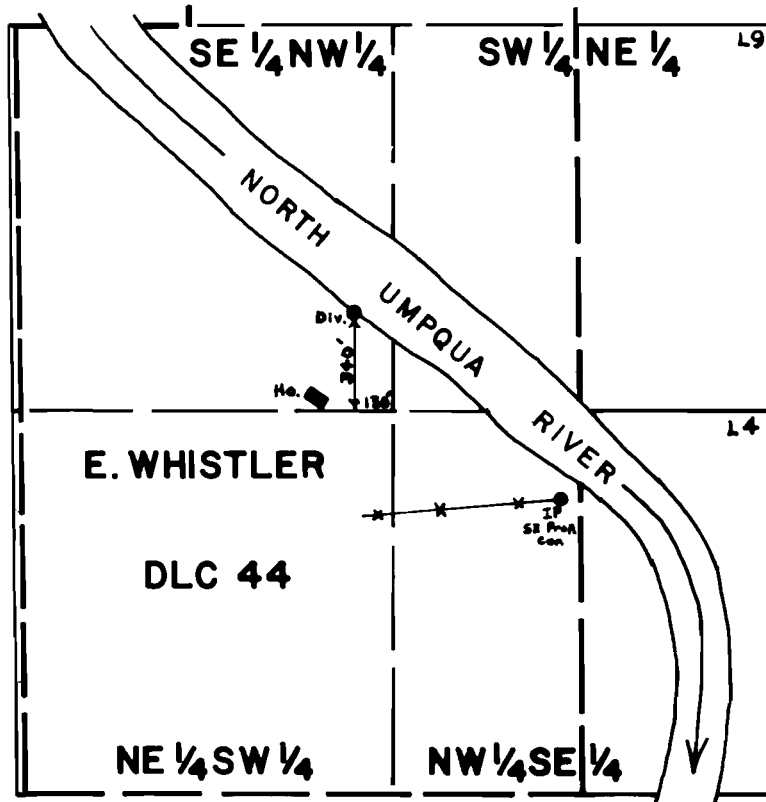

Scale: 1" = 660'

FINAL PROOF SURVEY
UNDER

Application No. 51124... Permit No. 38645...
IN NAME OF

WILLIAM S. & A. GAYLE MOFFITT

Surveyed OCT. 12 1977, by D.W. SPARKS