


T.30S. R.6W. W.M.

Sec. 1

SE 1/4 SE 1/4

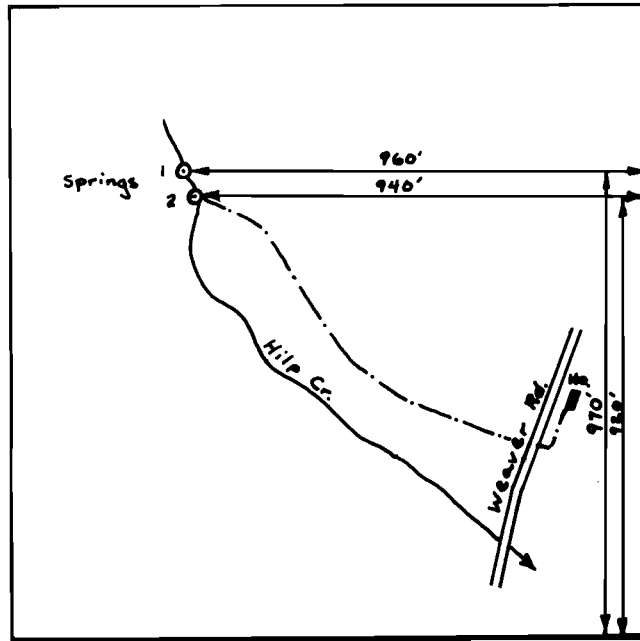

SCALE: 1" = 400'

FINAL PROOF SURVEY
UNDER

Application No. 54646 Permit No. 41007
IN NAME OF

Arleen Neale

Surveyed May 10 1978, by D. Sparks