


T.27S., R.6W., W.M.

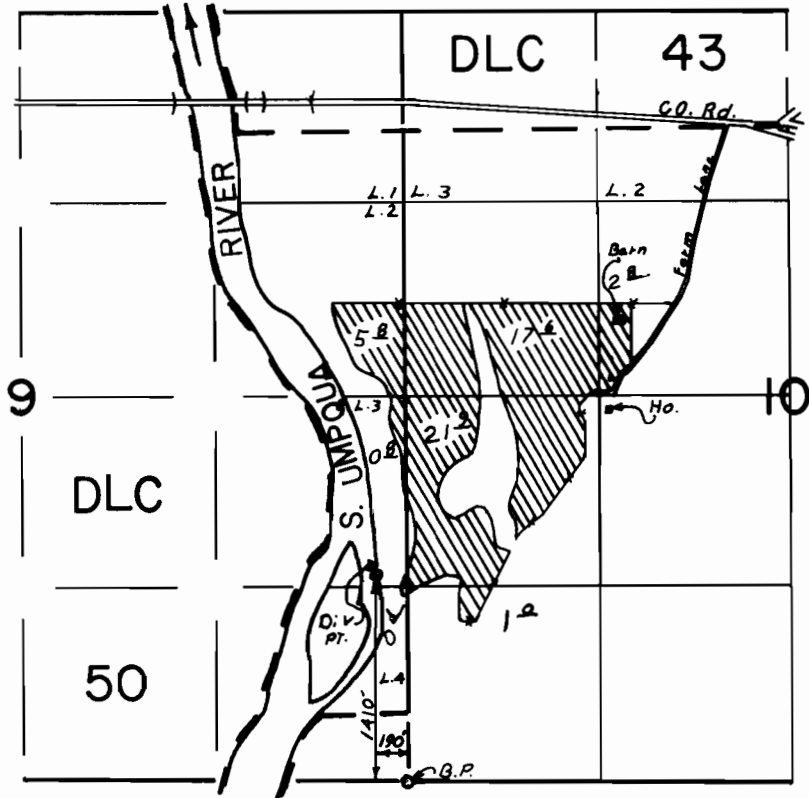

**FINAL PROOF SURVEY**  
UNDER

Application No. 50878 Permit No. 38417  
IN NAME OF

DR. DON BAILEY

Surveyed OCT. 14. 1977. by D.W. SPARKS.