


T.26 S., R.6 W., W.M.

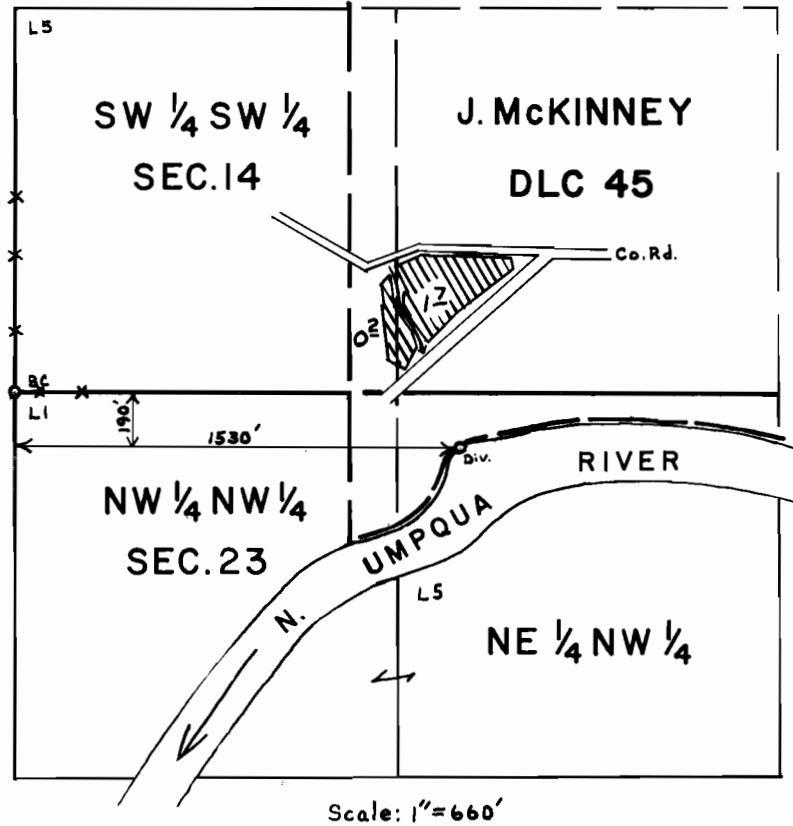

**FINAL PROOF SURVEY**  
UNDER

Application No. 50450 Permit No. 38104  
IN NAME OF

**JAMES N. LARAUT**

Surveyed OCT. 10. 1977, by D.W. SPARKS.