


T.26 S., R.7 W., W.M.

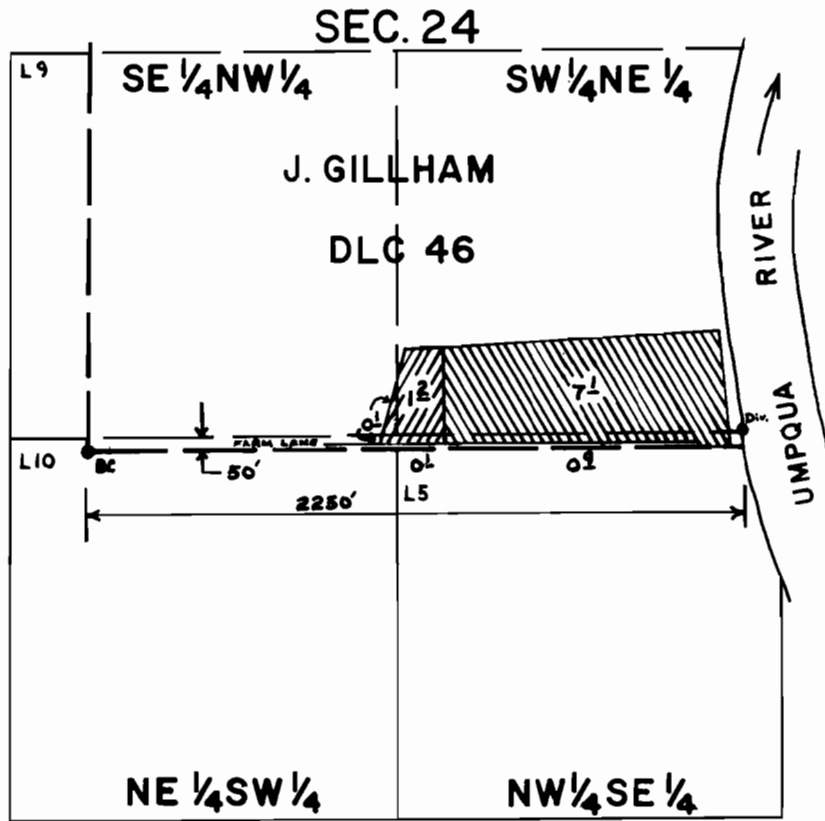

Scale: 1" = 660'

FINAL PROOF SURVEY
UNDER

Application No. 52867 Permit No. 39900
IN NAME OF

JACK L. & GWENDOLYN A. FARMER

Surveyed NOV. 7, 1977, by D.W. SPARKS