


T. 26 S., R. 3 W., W.M.

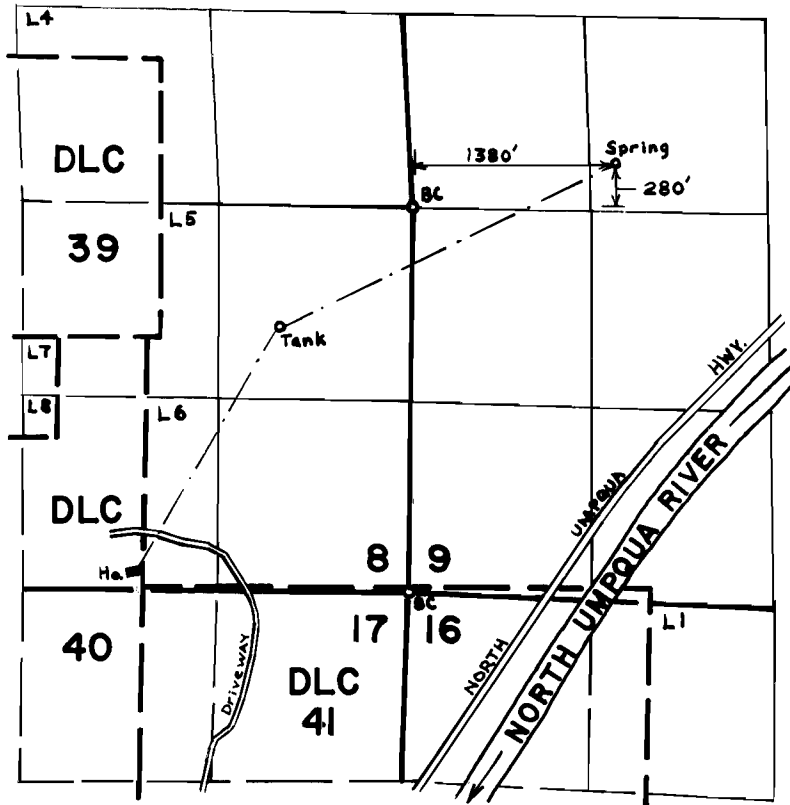

FINAL PROOF SURVEY
UNDER

Application No. 57171 Permit No. 43061
IN NAME OF

WILLIAM DAVID & CAROLYN JO STRADER

Surveyed OCT. 18 1978, by D.R. HENRY